




Plat of the Mary H. Seeds farm in Jackson Sp. Survey 1105  
T.M.C. INDEX 1889

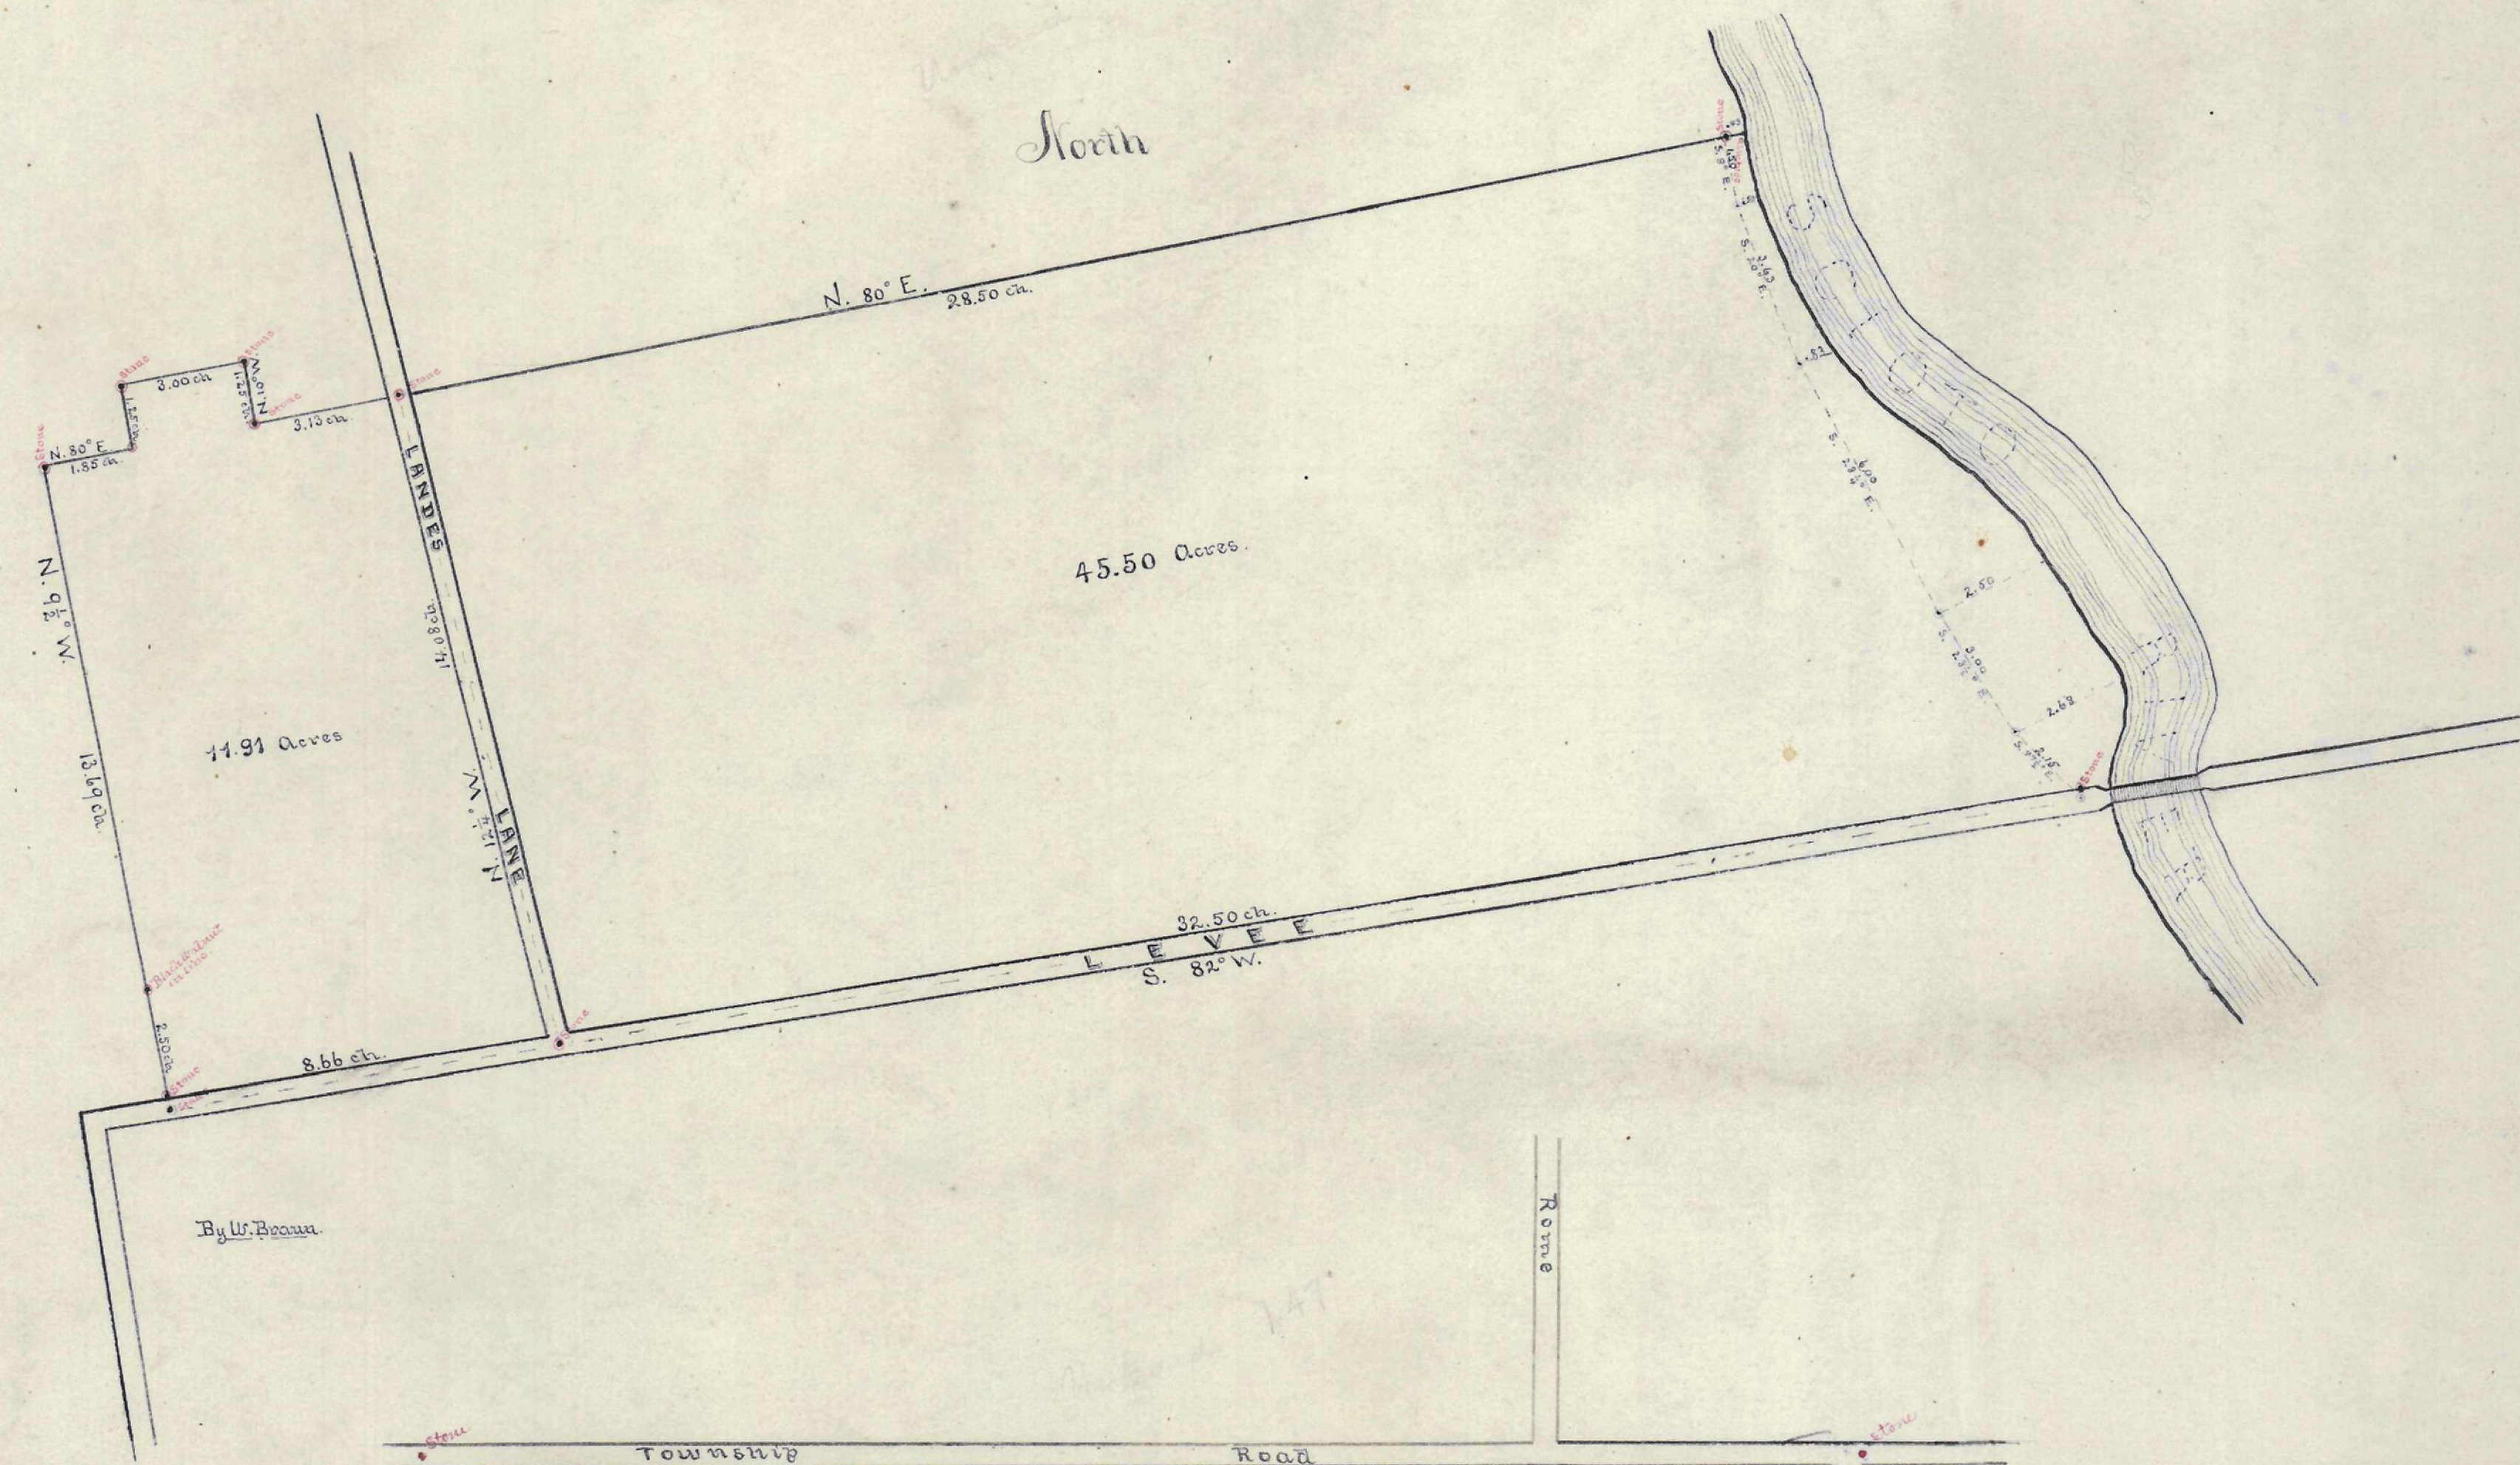

Plat. Youngs Riv.  
of the Peterkingery Farm in Pleasant Sp. Franklin Co. O. Survey No 1178. T.M.C.  
Surveyed Feb. 25. 89. G.S. Index INDEX

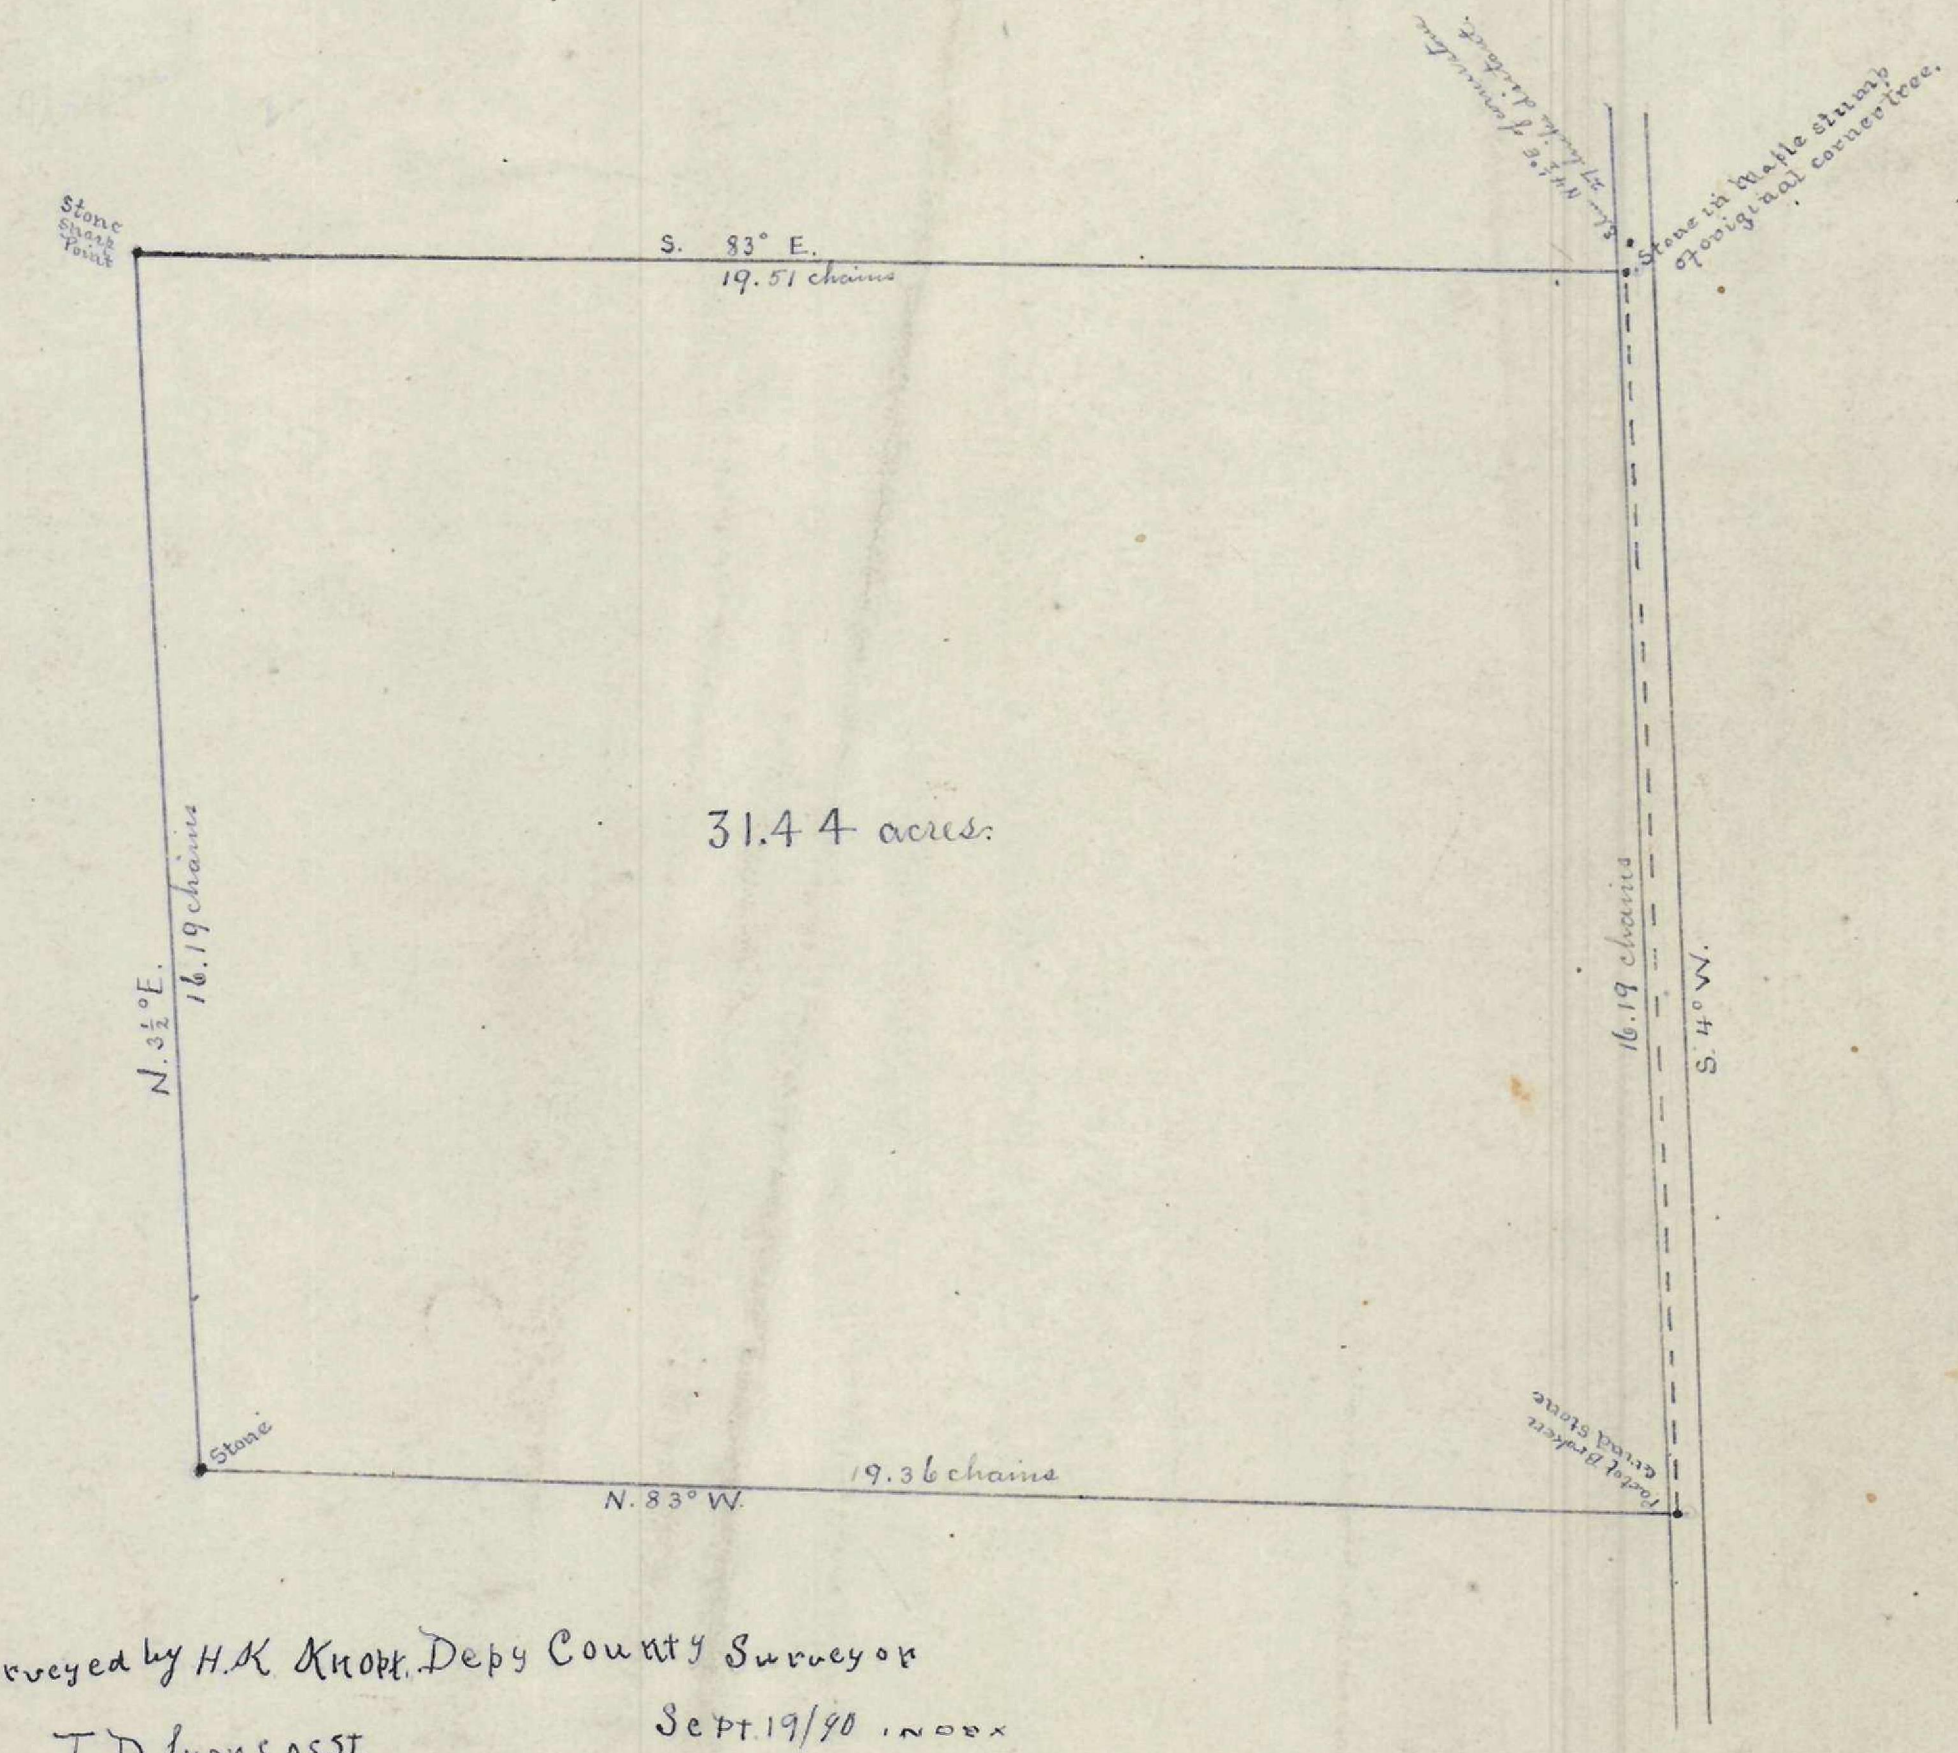

Plat of the Geo. Emde and Leopold Meyer farms in Jackson Sp. Franklin Co. in Survey 1473 T.M.C. INDEX 1889

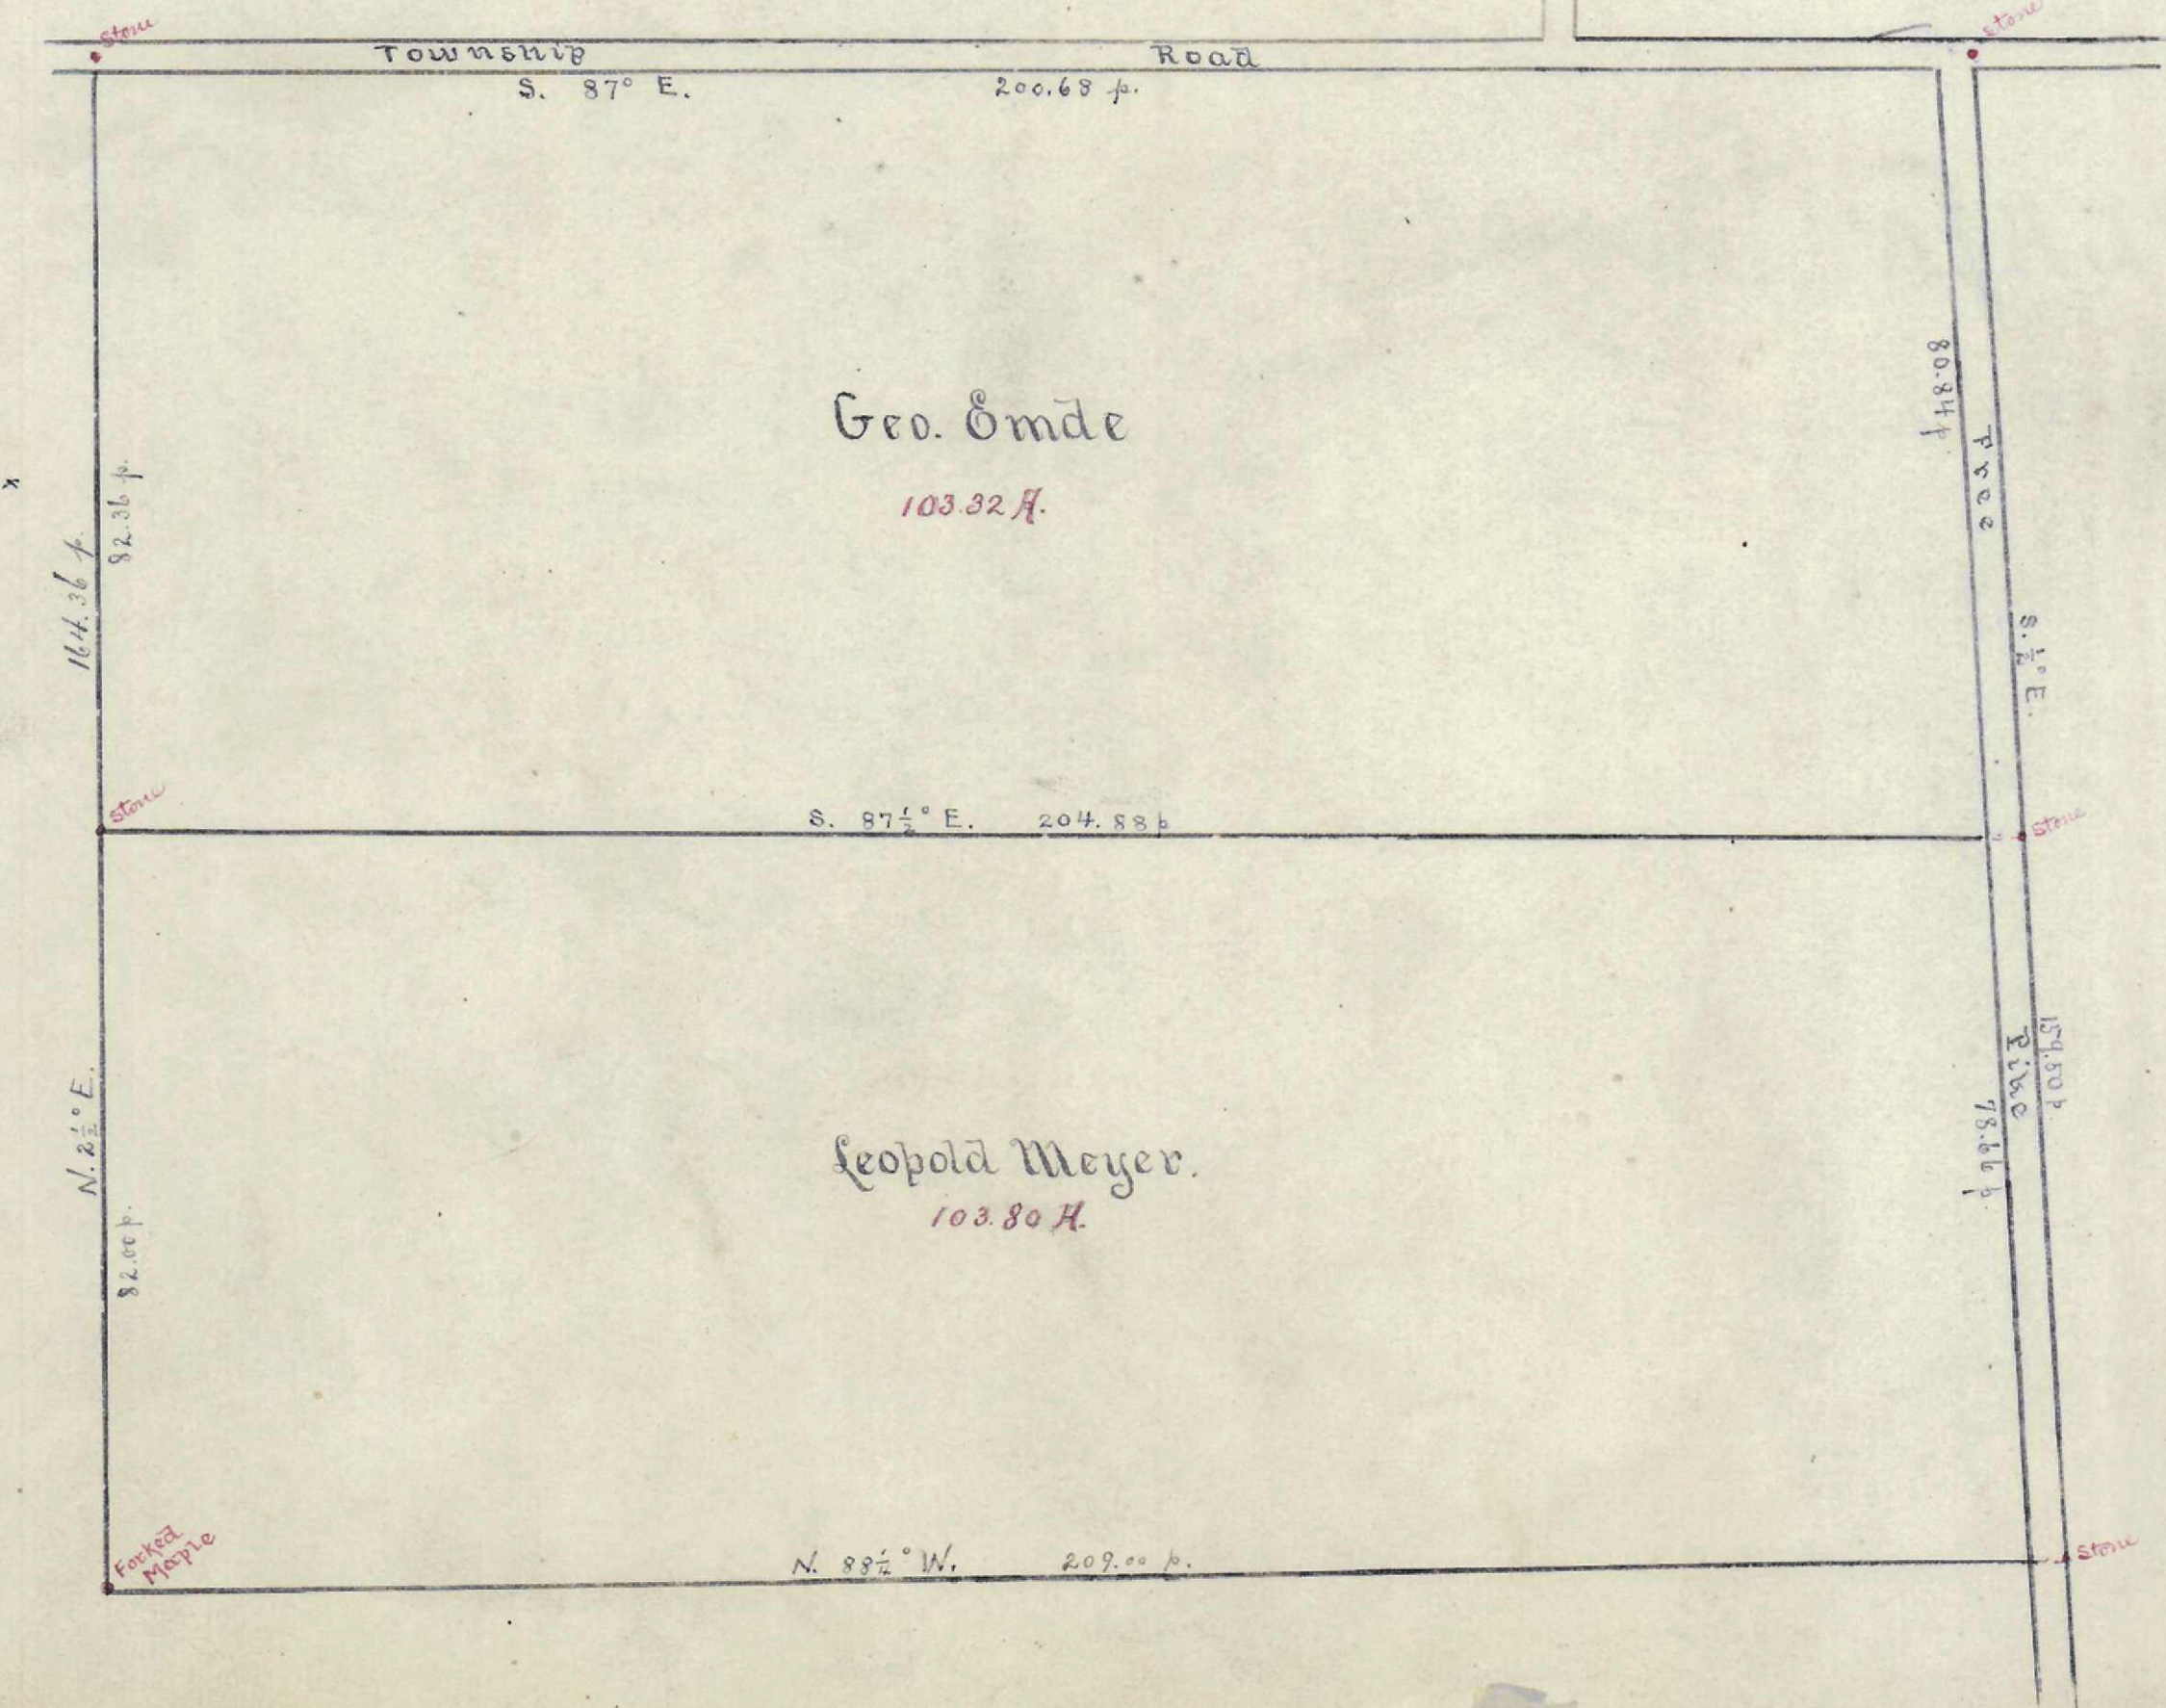


