





Survey of 45<sup>15</sup> Acres of land  
 in ~~Franklin~~ Sp. Franklin Co. O. for Albert  
 M<sup>c</sup>Calla by Walter Braun D.C.S.  
 Saml Martin Chas Jennings } chairman  
 April 29, 1891.

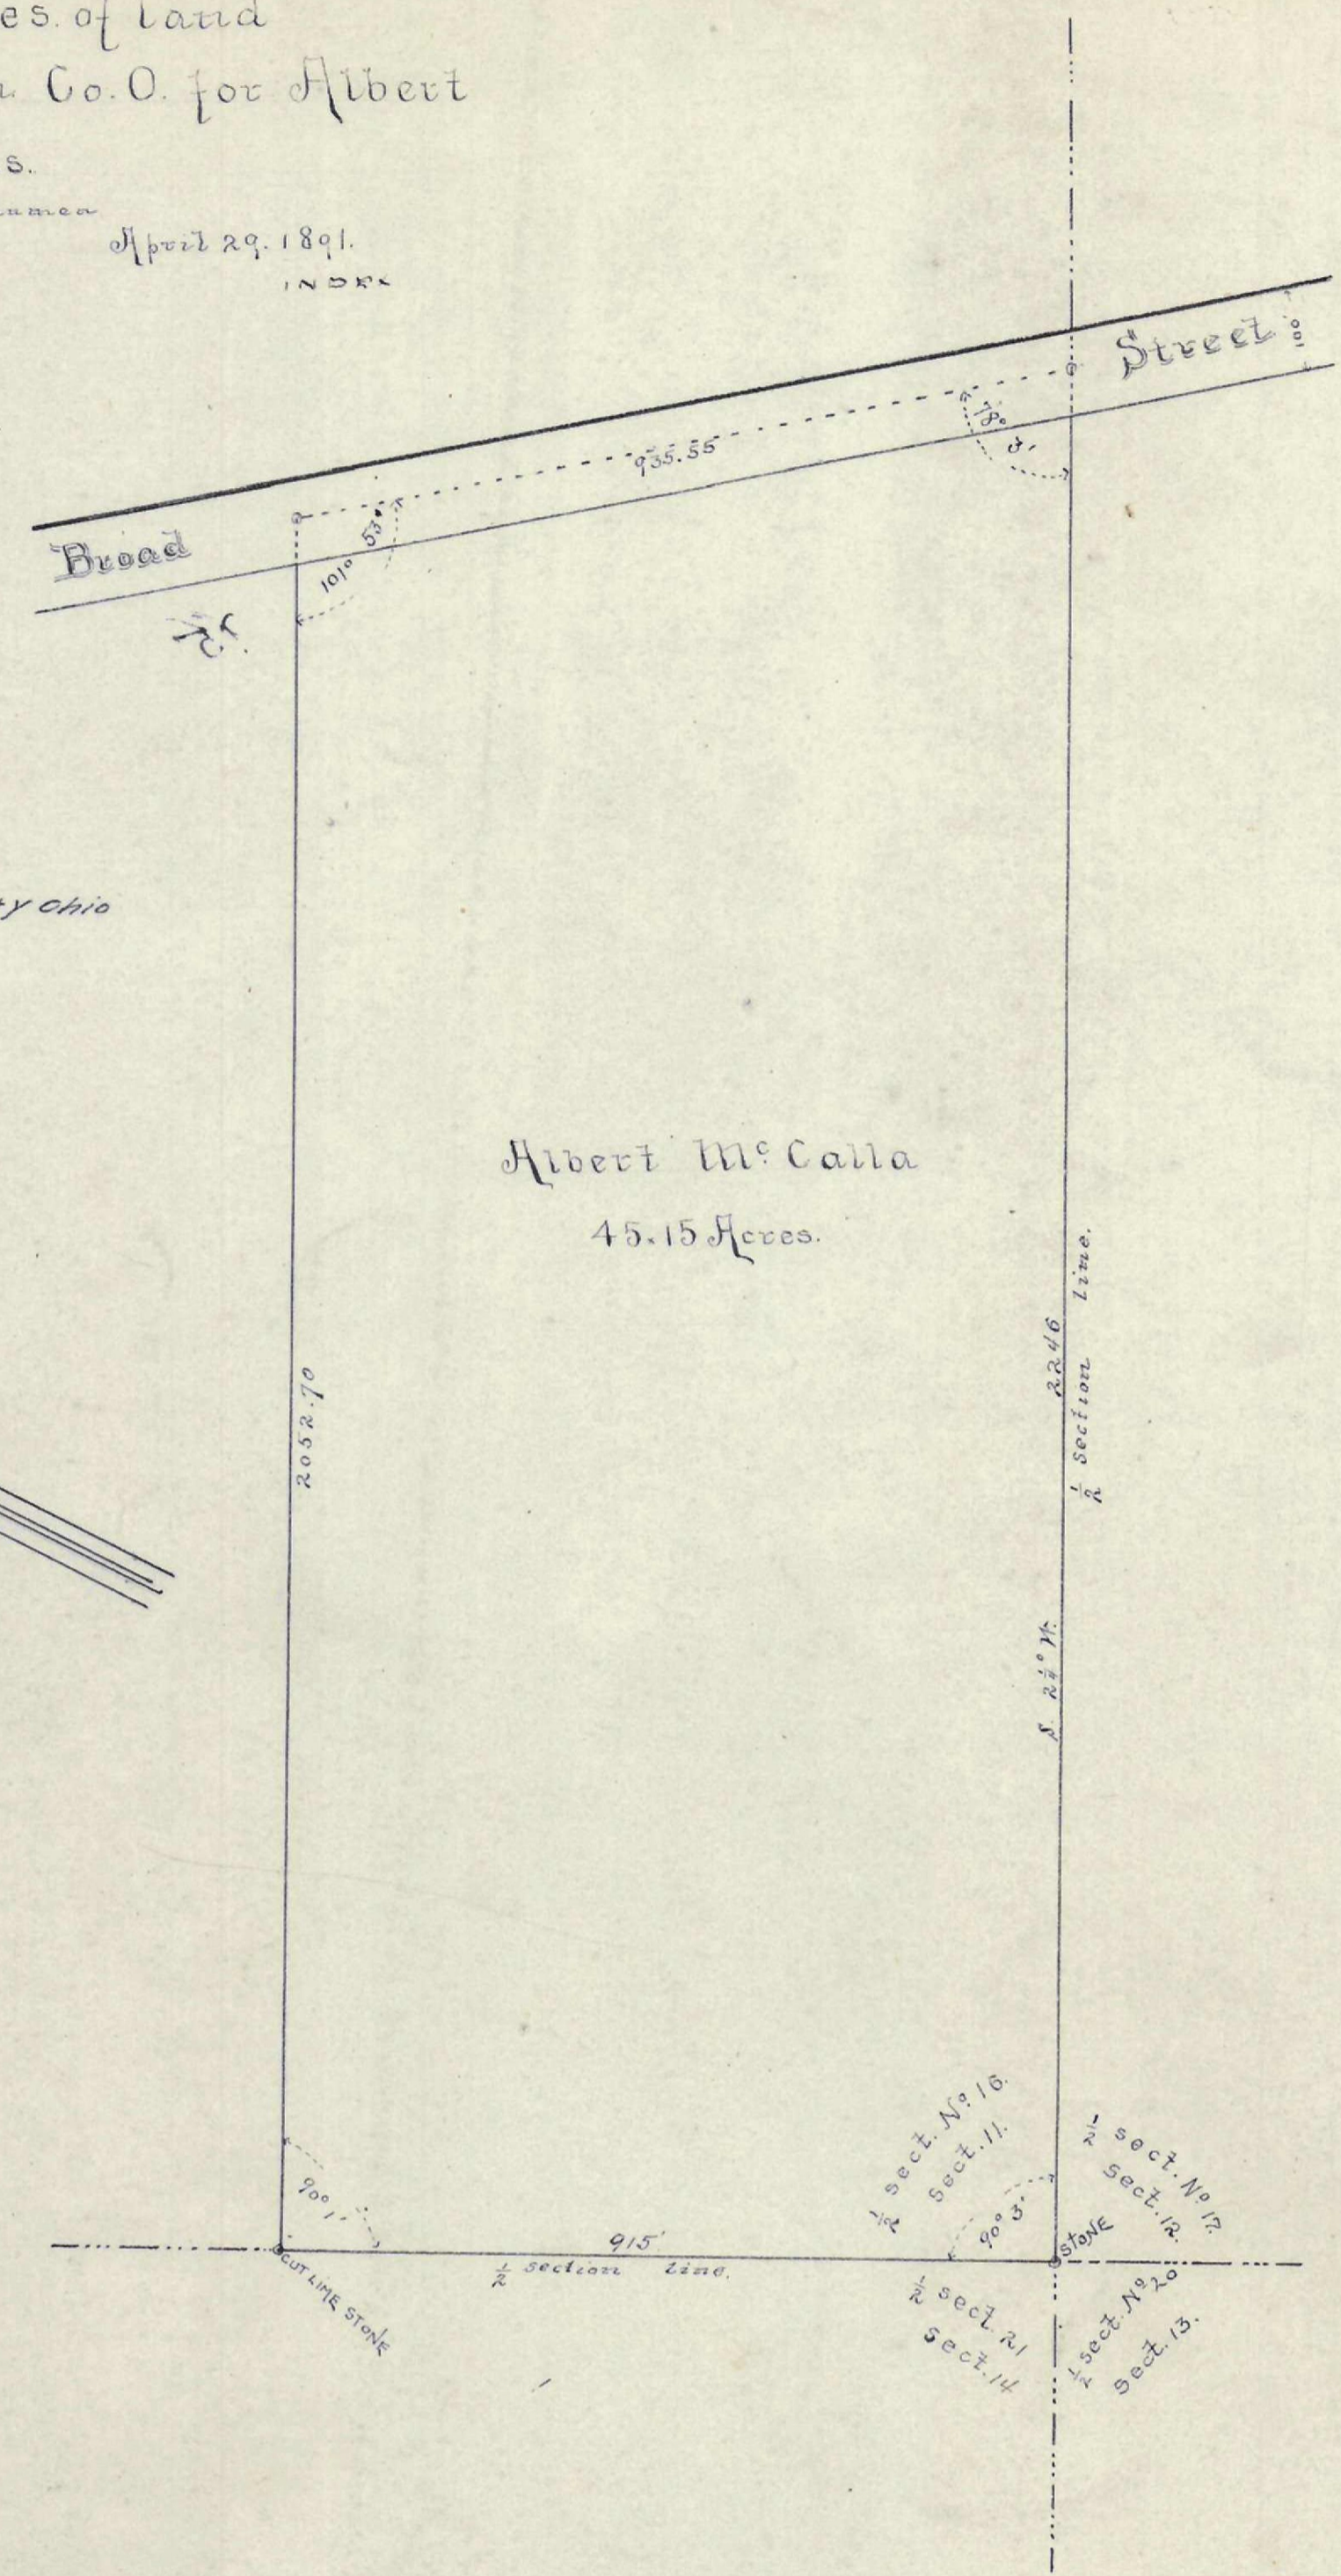


Plat of Terecia Ernest farm  
 being part of surveys Nos. 2608 & 2609  
 situated in Adams Township Franklin County Ohio  
 survey made September 1887  
 by John Court right surveyor

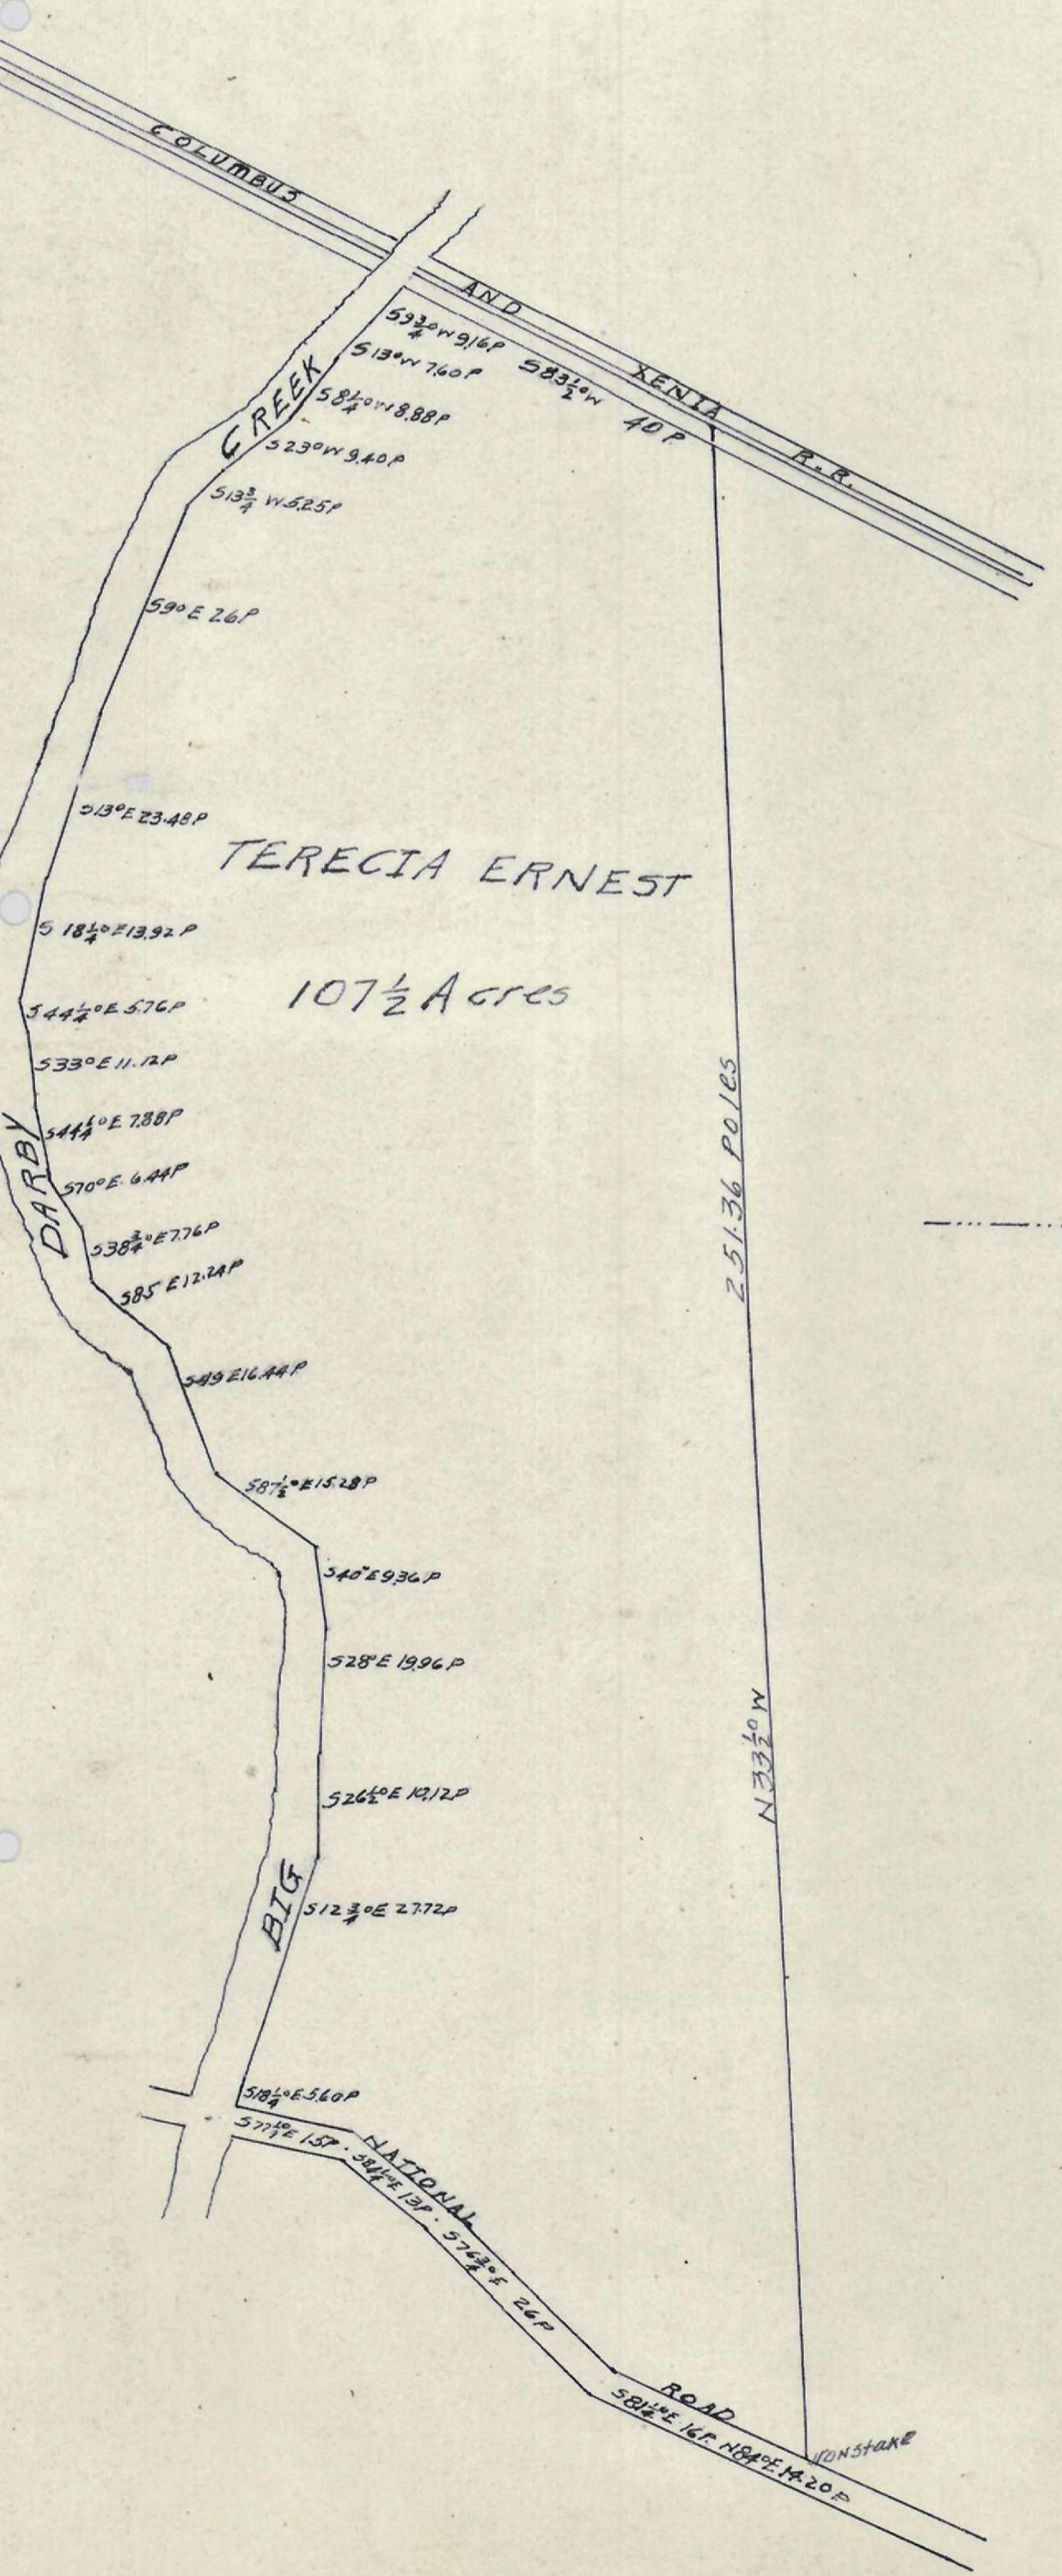

Survey of 138<sup>46</sup> Acres of land in Clinton Sp. Franklin Co. O.  
 for H. C. Doney. Being lot 23 and lots 22 & 24 of a partition on record  
 in Clark's Office. Complete Record Book 64 Page 107.  
 By Walter Braun, D.C.S. June 20, 1890.  
 R. L. Dancy Paul Radzberg } chairman

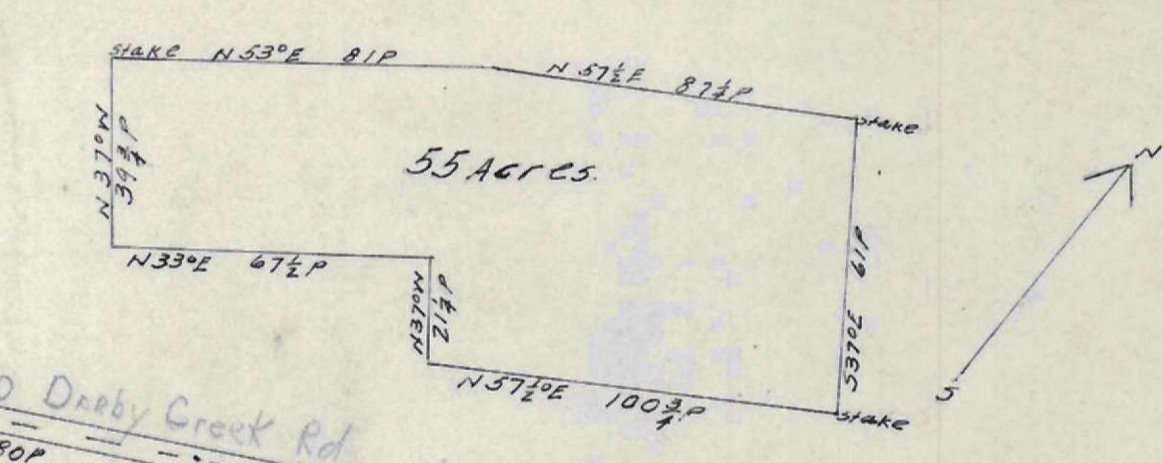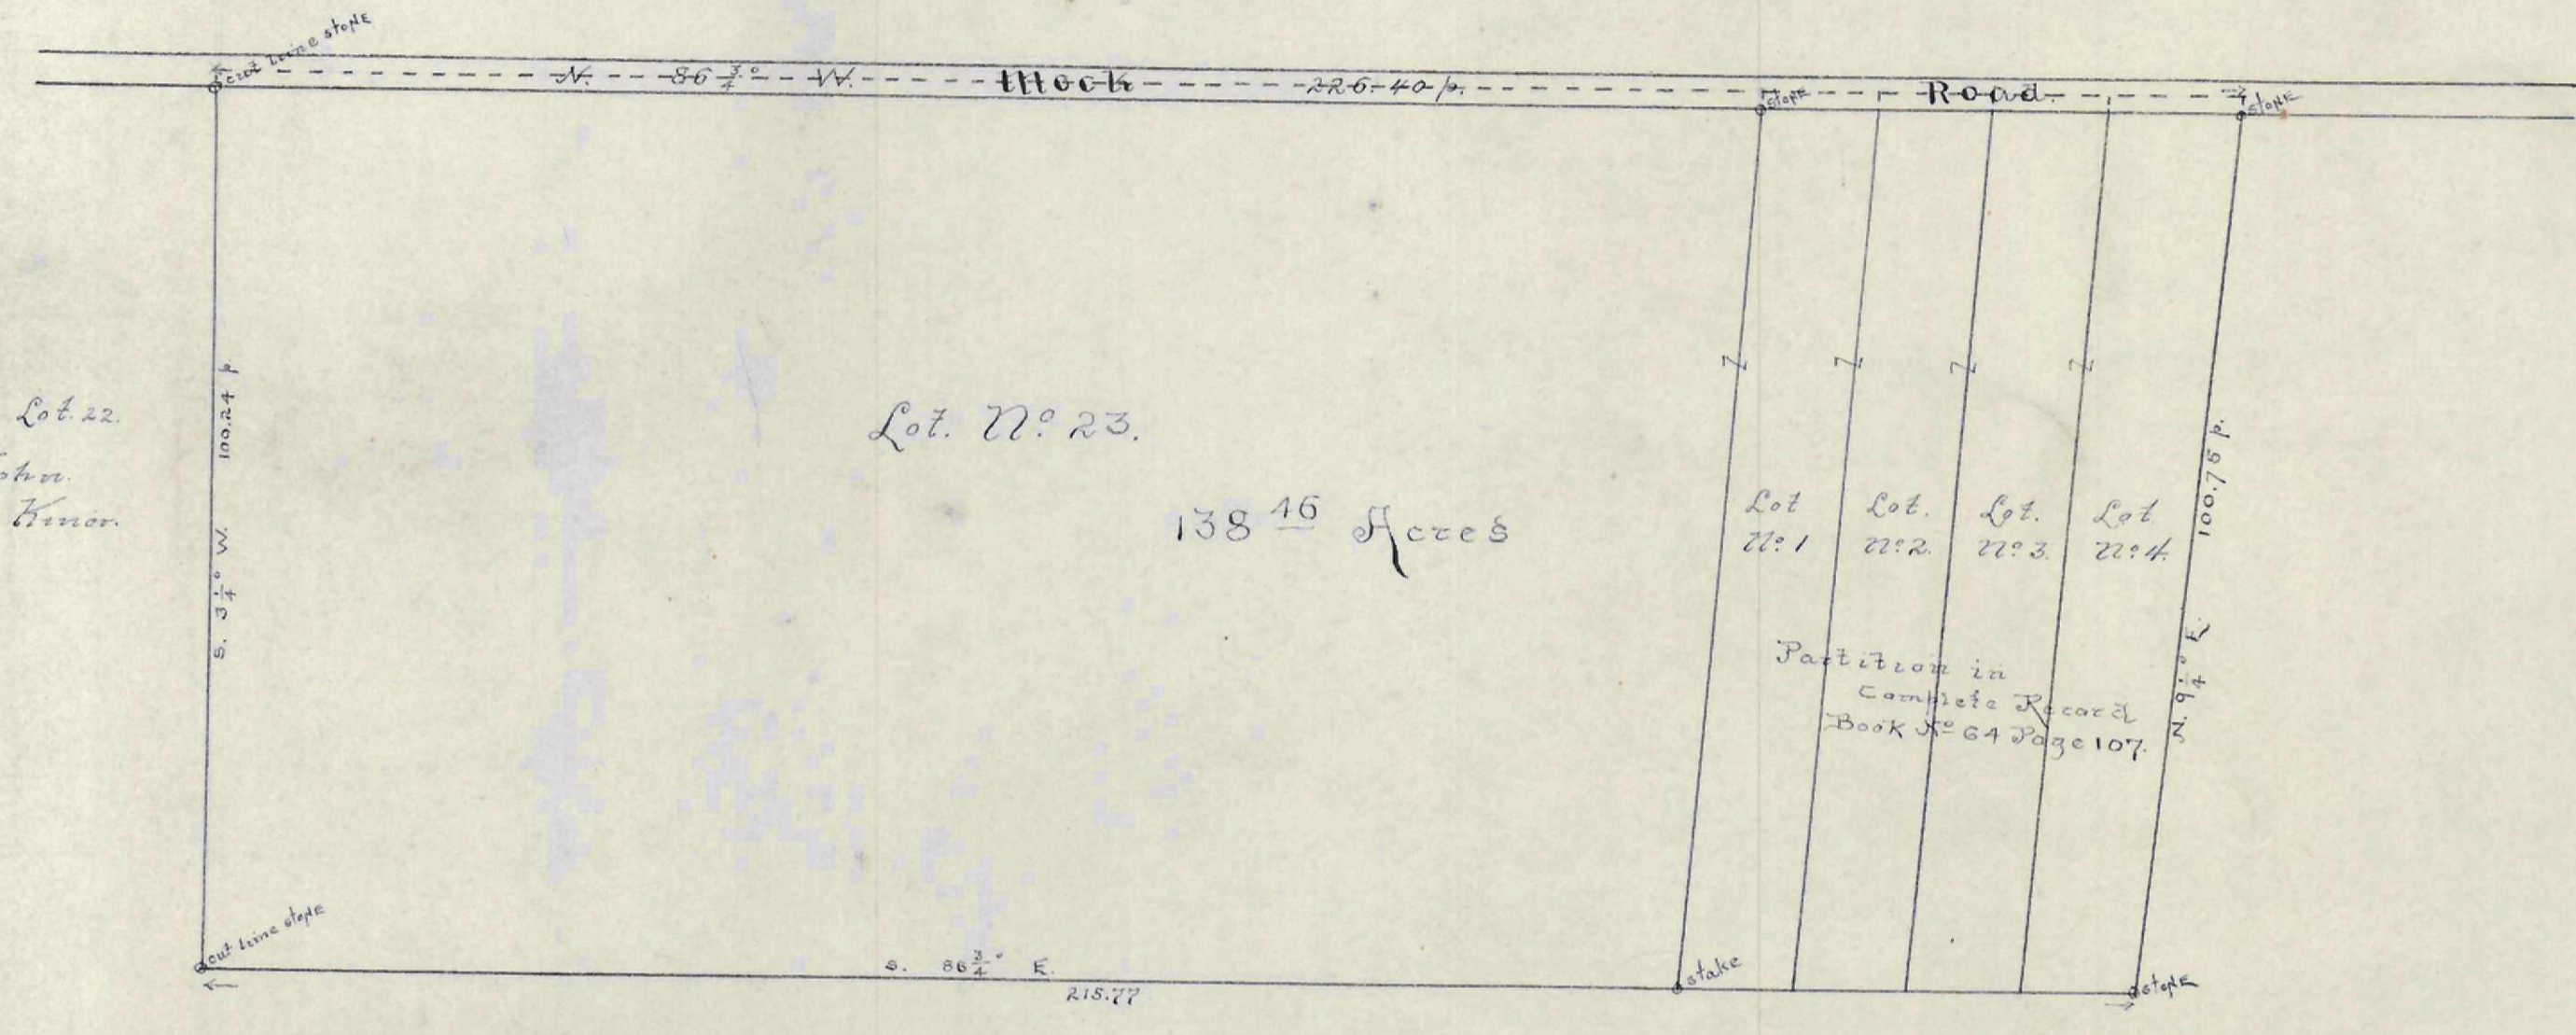

Plat of Isaac Bonser  
 Estate Brown Township  
 Franklin County Ohio  
 Vm Survey of 660 1849

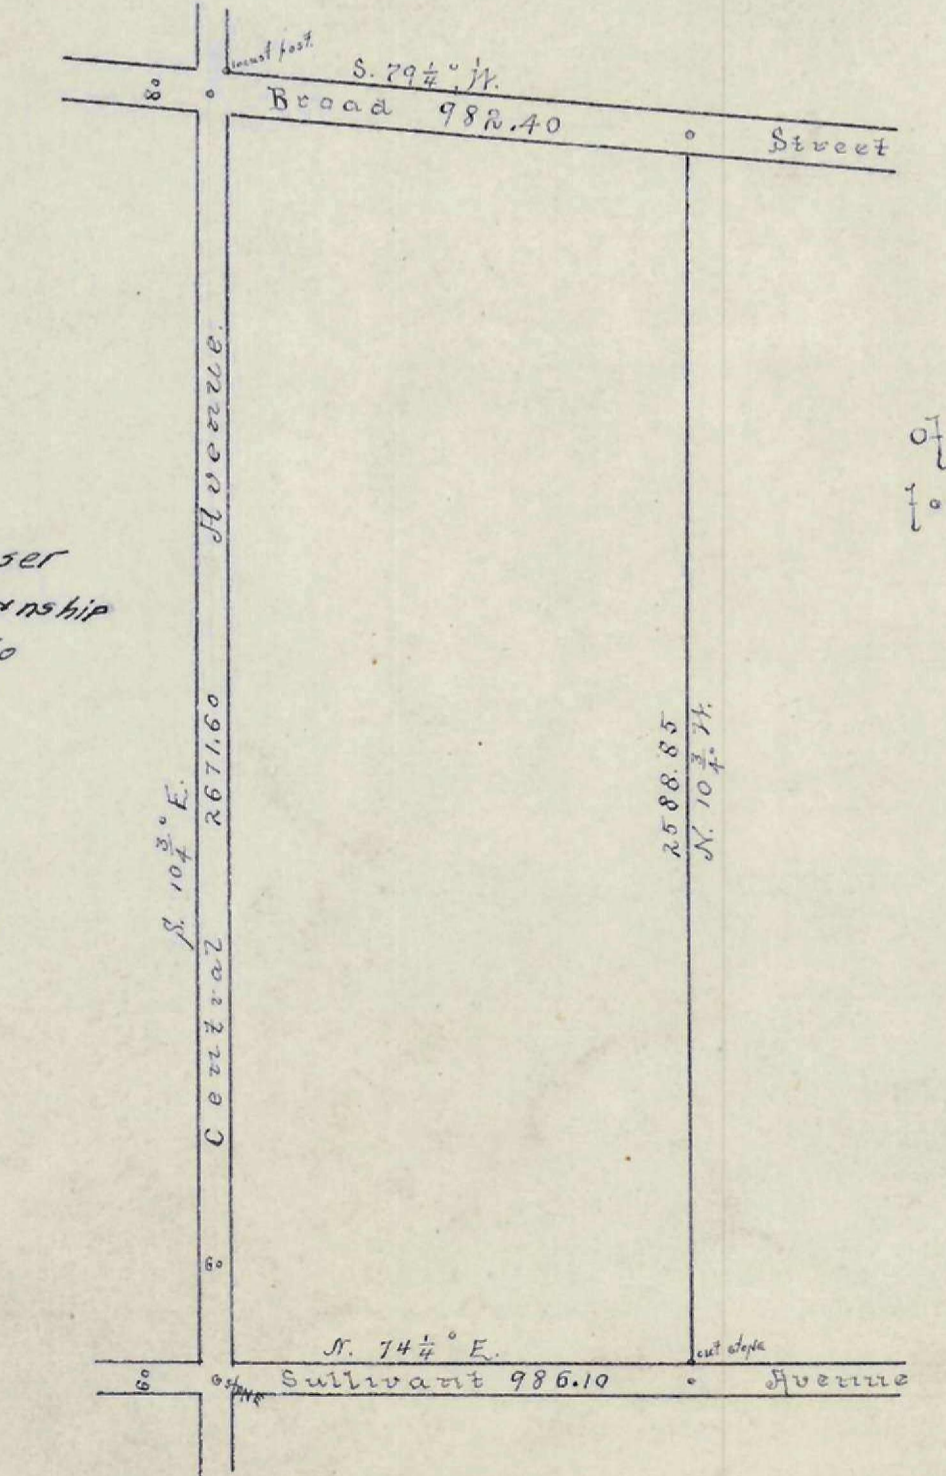

Survey of Lots 9, 10, 11, 12  
 of M. L. Sullivan's Western Addition  
 for Simon's Bros. Feb. 17, 1891.  
 By Walter Braun Deputy Co. Surveyor  
 Frank Bink Chairman