

Plat of the Land as surveyed and divided for the Heirs of James Baker deceased being a part of the south half of lot No. 5 of original Survey 1383 Virginia Military Lands March 4th 1870. B.F. Bowen Surveyor Franklin County Ohio Jackson Tp.


PLAT

Of the partition of the Estate of Eliza Wilson among his heirs. Situated in Franklin Township Franklin County Ohio.

Surveyed and Platted Dec. 23rd 89 By John J. Dunn C.S. per E.C. Seeger asst. INDEX



PLAT
 Of a part of Lot 33, M.L. Sullivan's Lots West of Columbus. Platted by John Graham on file in Recorder's Office.
 Surveyed by John J. Dunn C.S. Jan. 3, 1890. INDEX

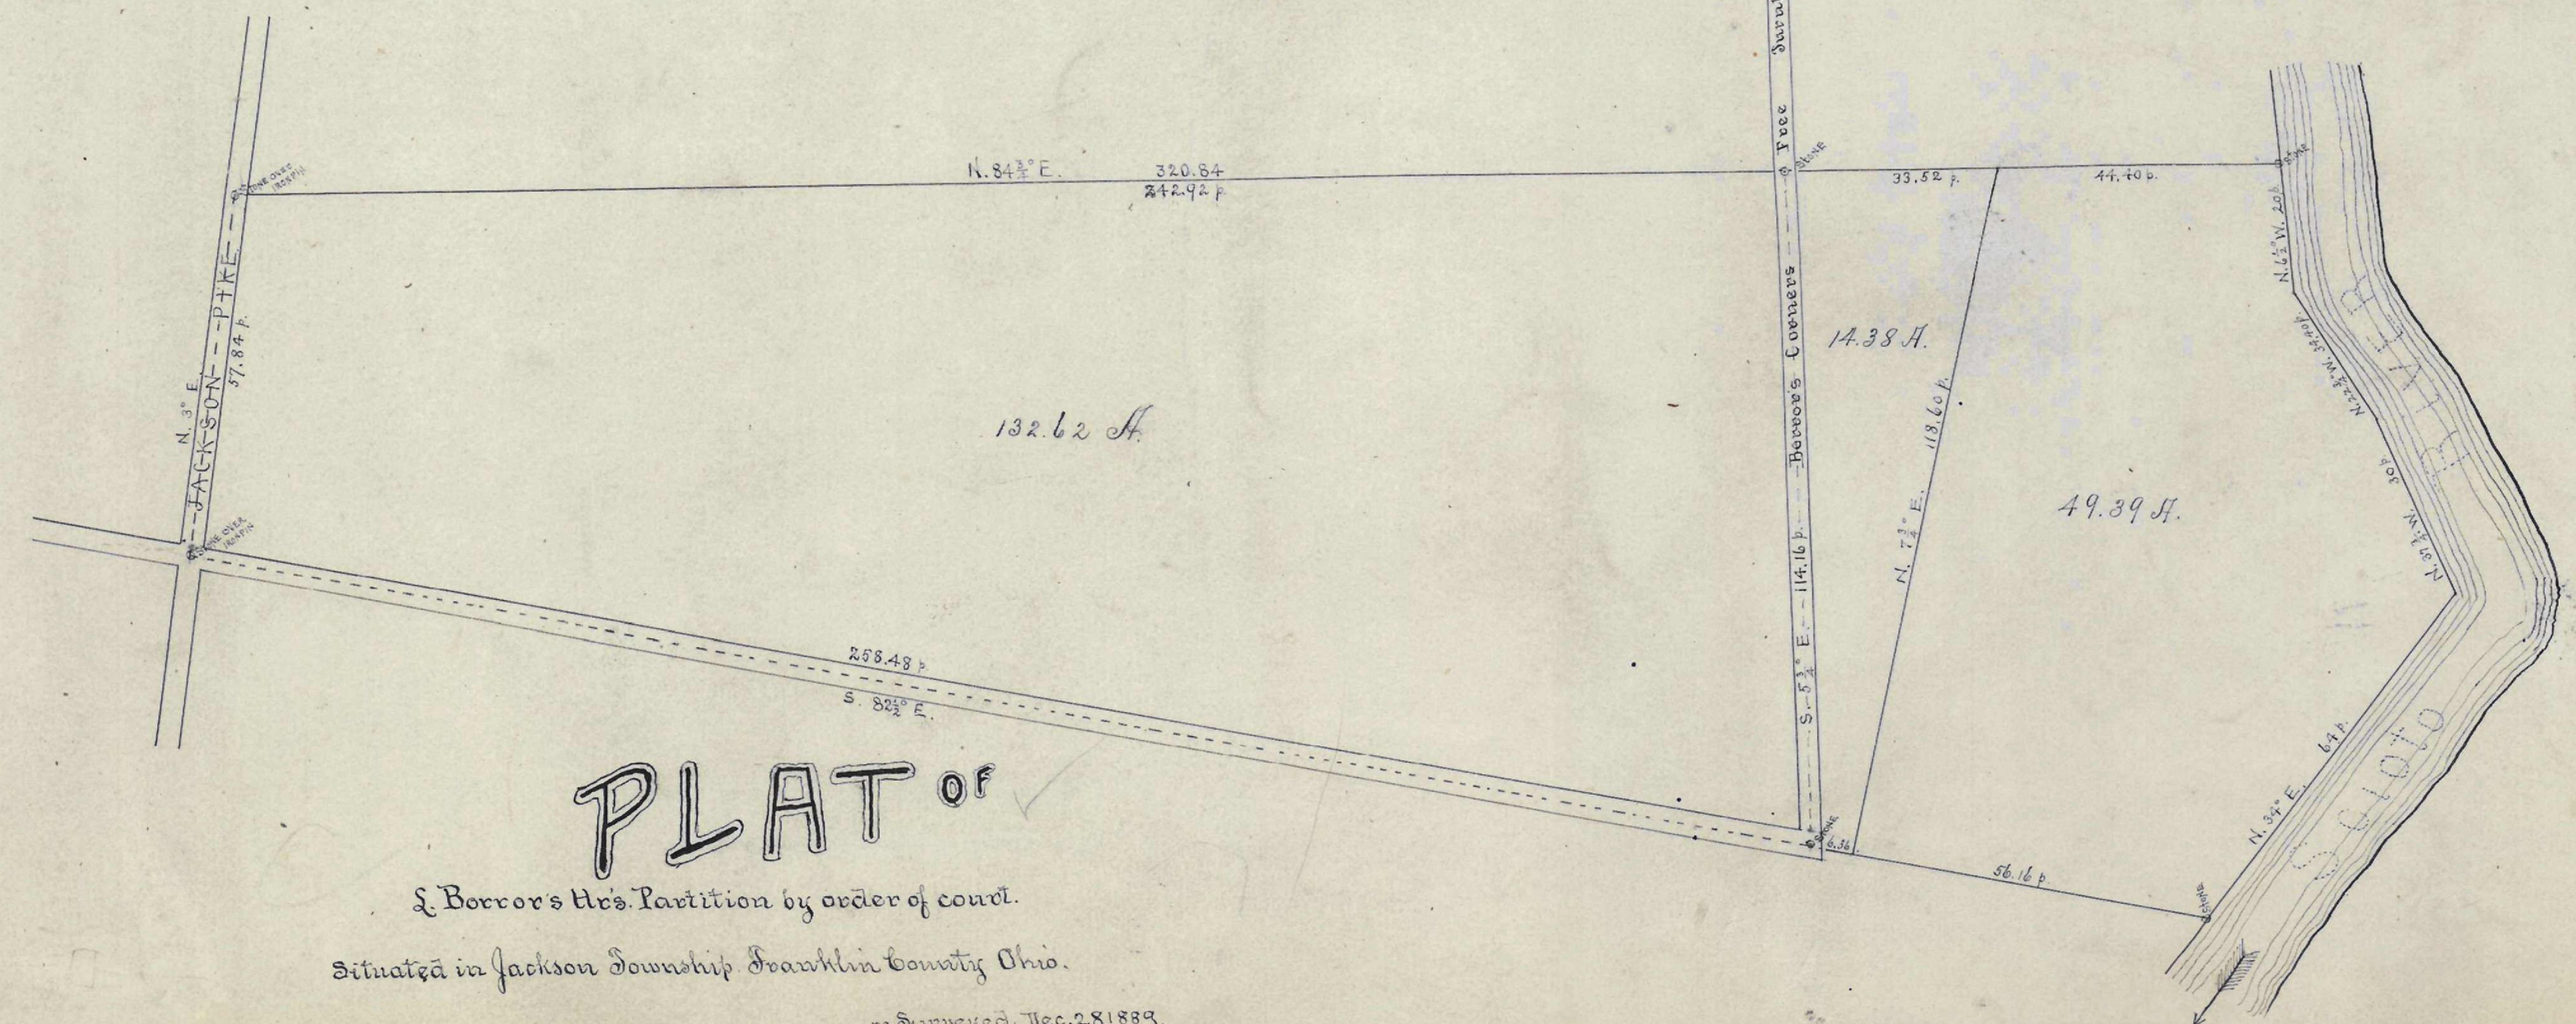

PLAT

of
 Borrow's Tr's Partition by order of court.
 Situated in Jackson Township Franklin County Ohio.

re-surveyed Dec. 28, 1883.
 By John J. Dunn C.S.
 per E.C. Seeger asst. INDEX