



PLAT OF AGGRANT'S Land


Part of JACKSON Twp. O. 1889

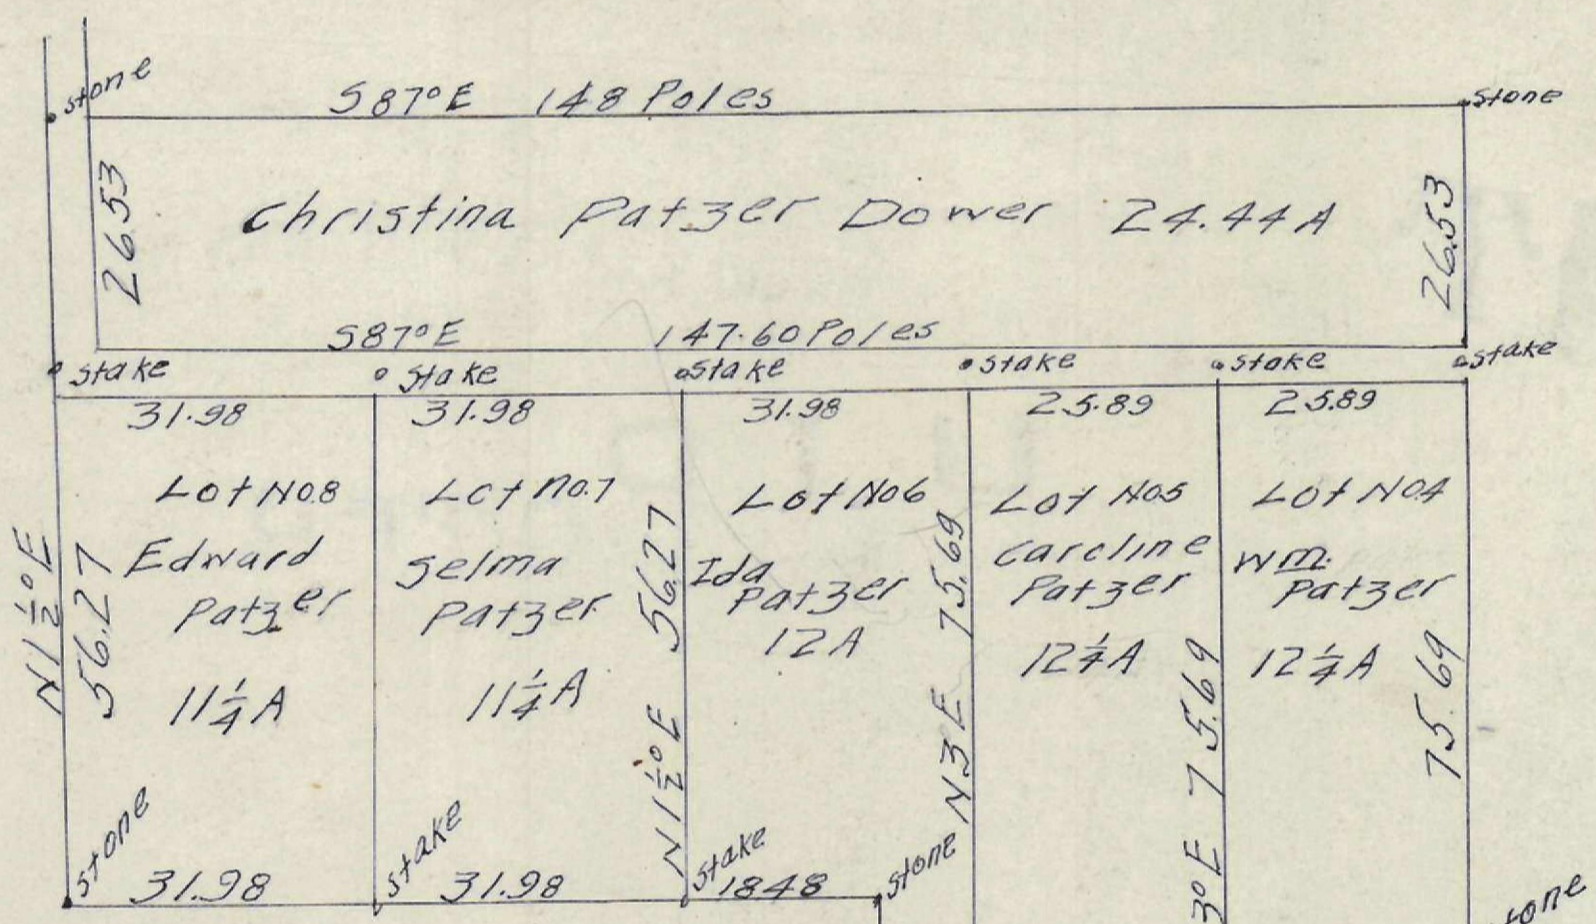



Plat of the Partition of the Lands of Henry Patzer deceased Sept. 30th 1881 V.M. Survey No. 1383 Jackson Township Franklin County Ohio

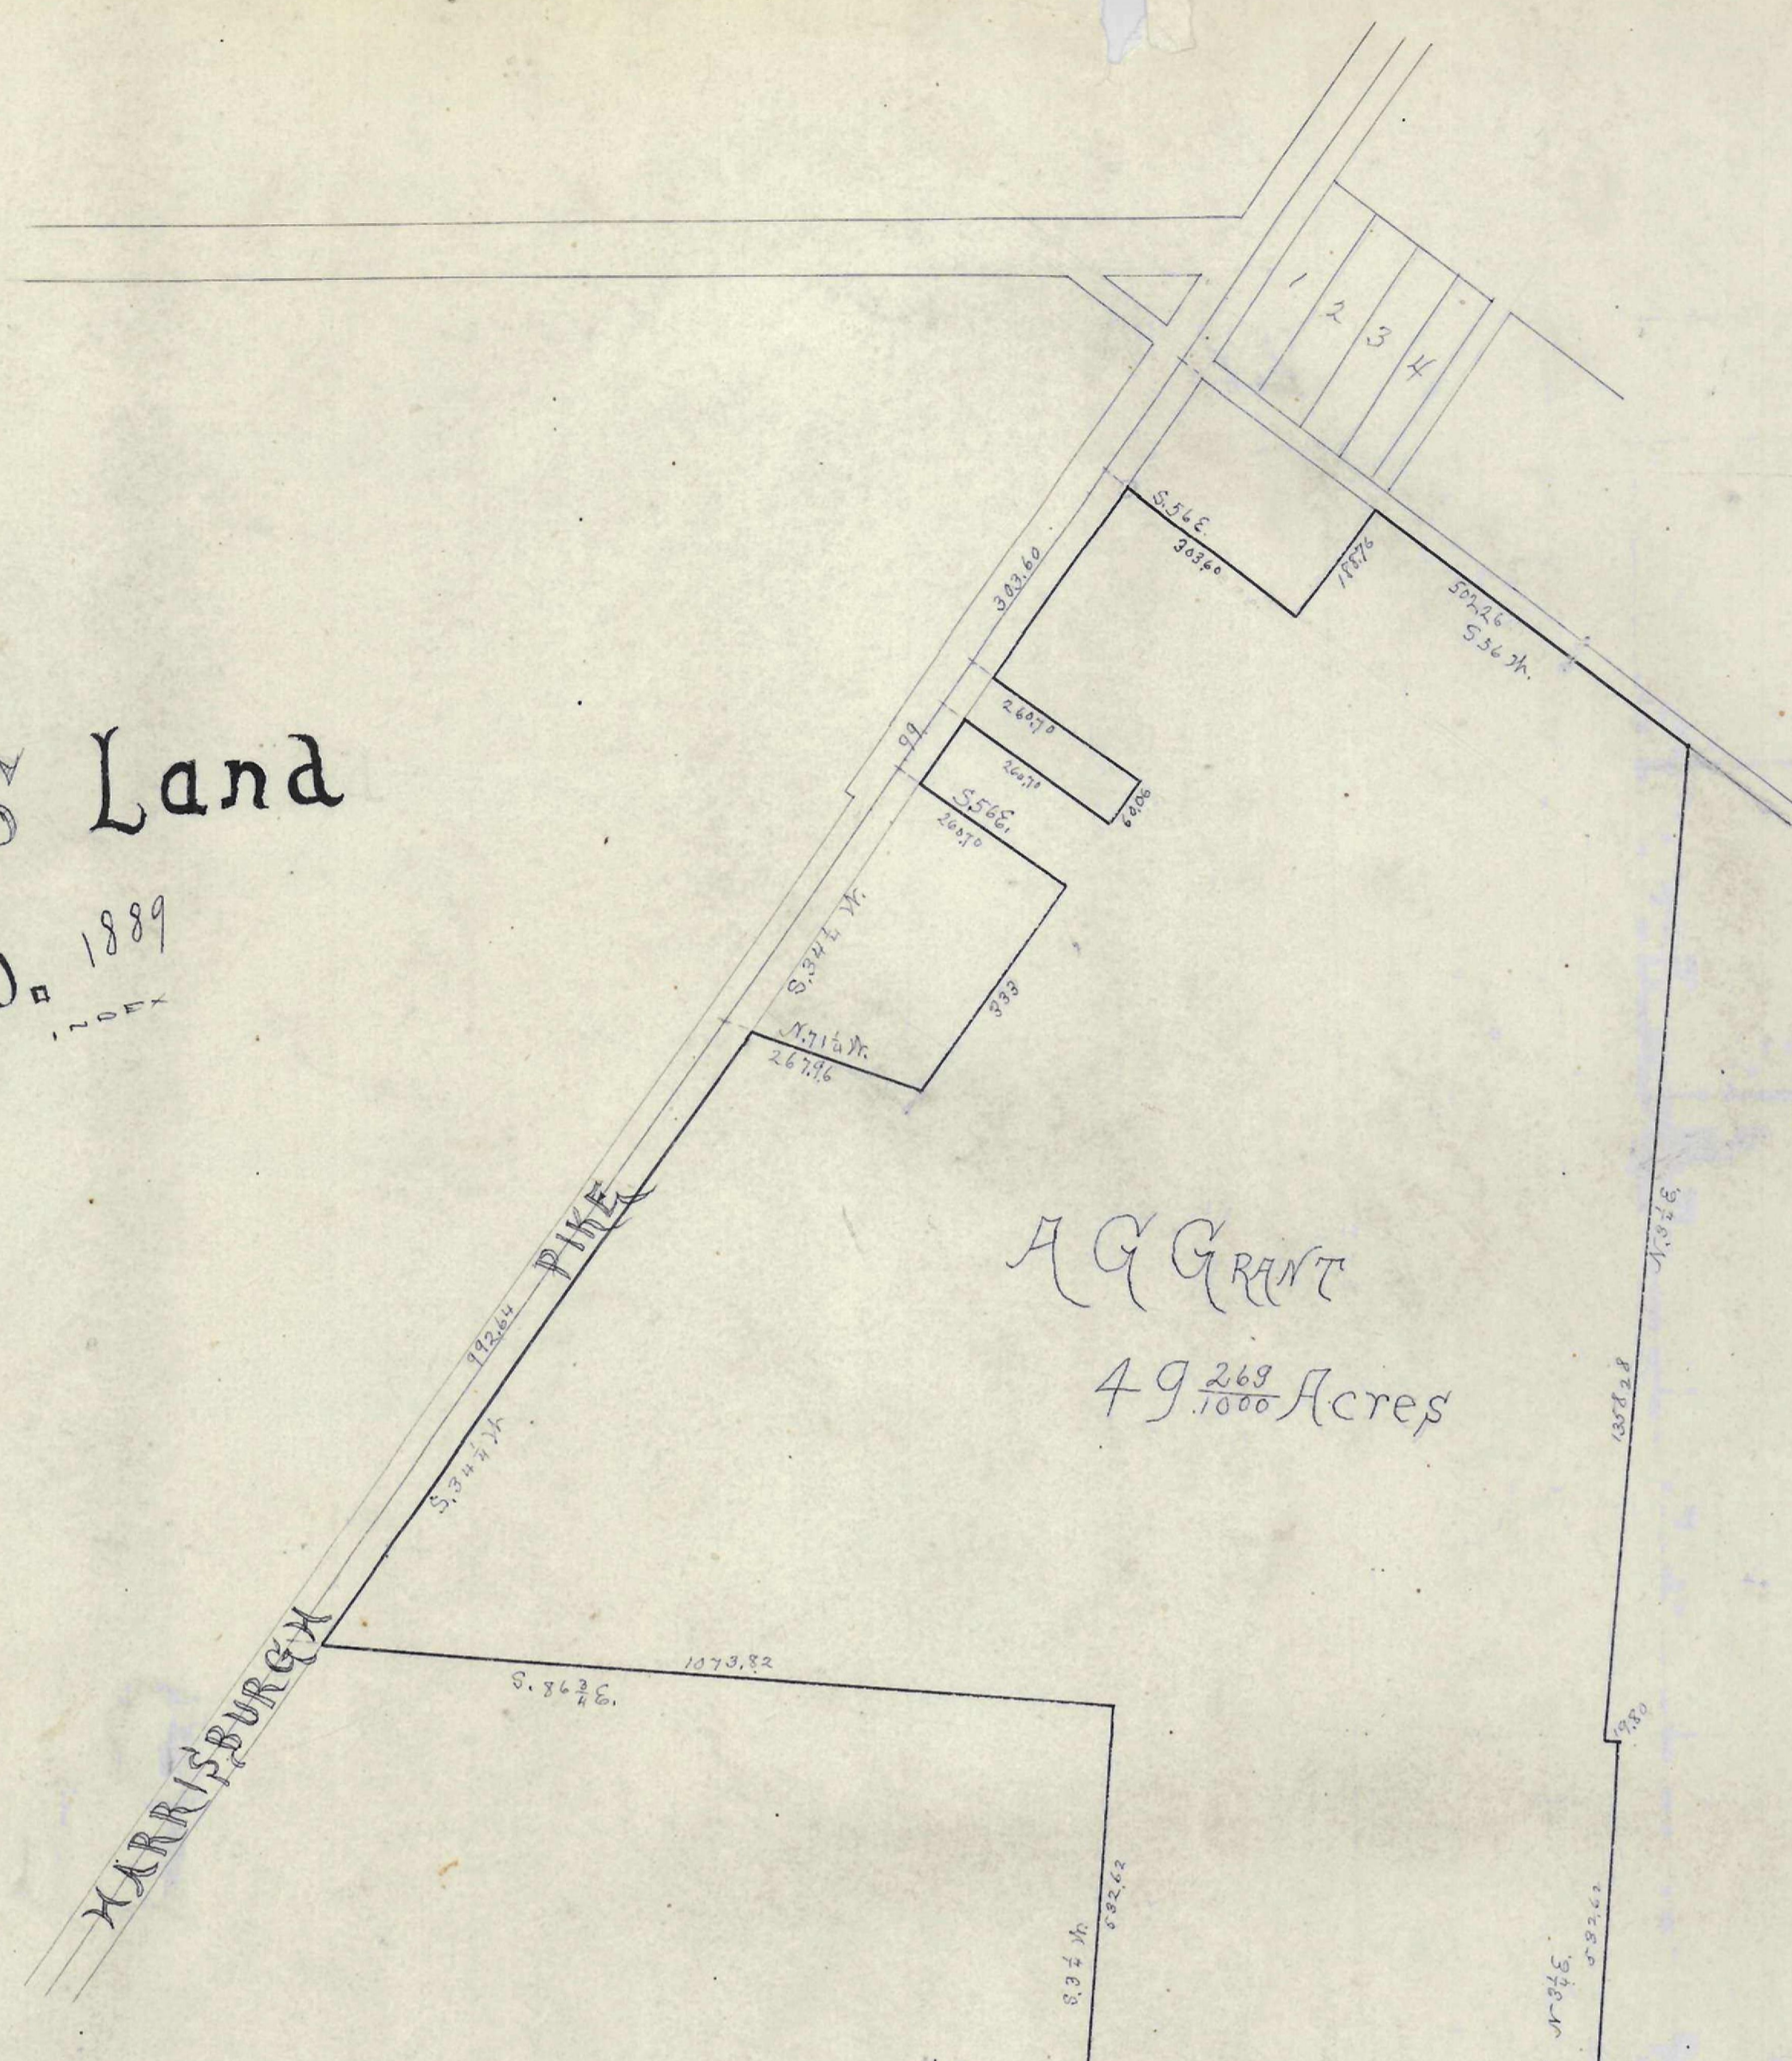

Plat B of Abraham Haughns Land in Jackson Twp. Survey 1371

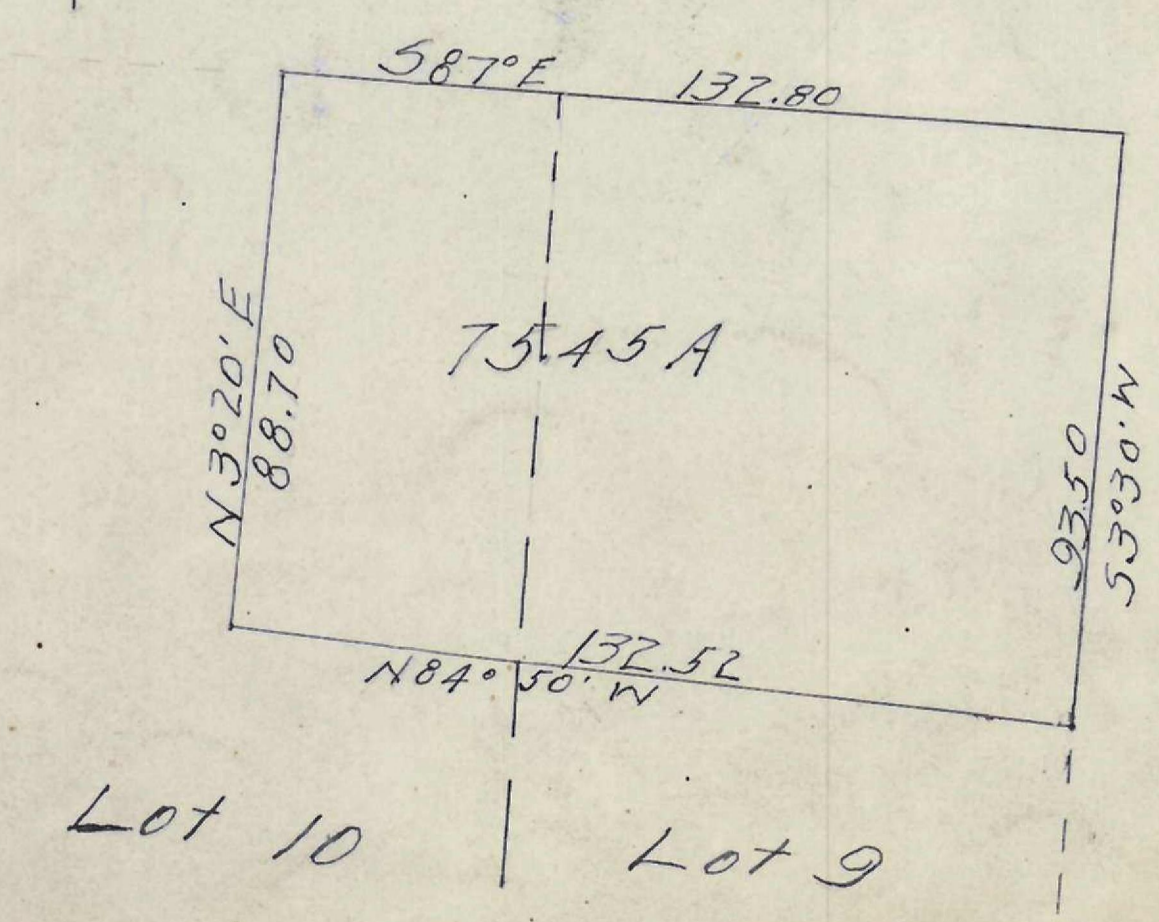

Plat B of the subdivision of Abraham Haughns land Jackson Twp. Survey 1371

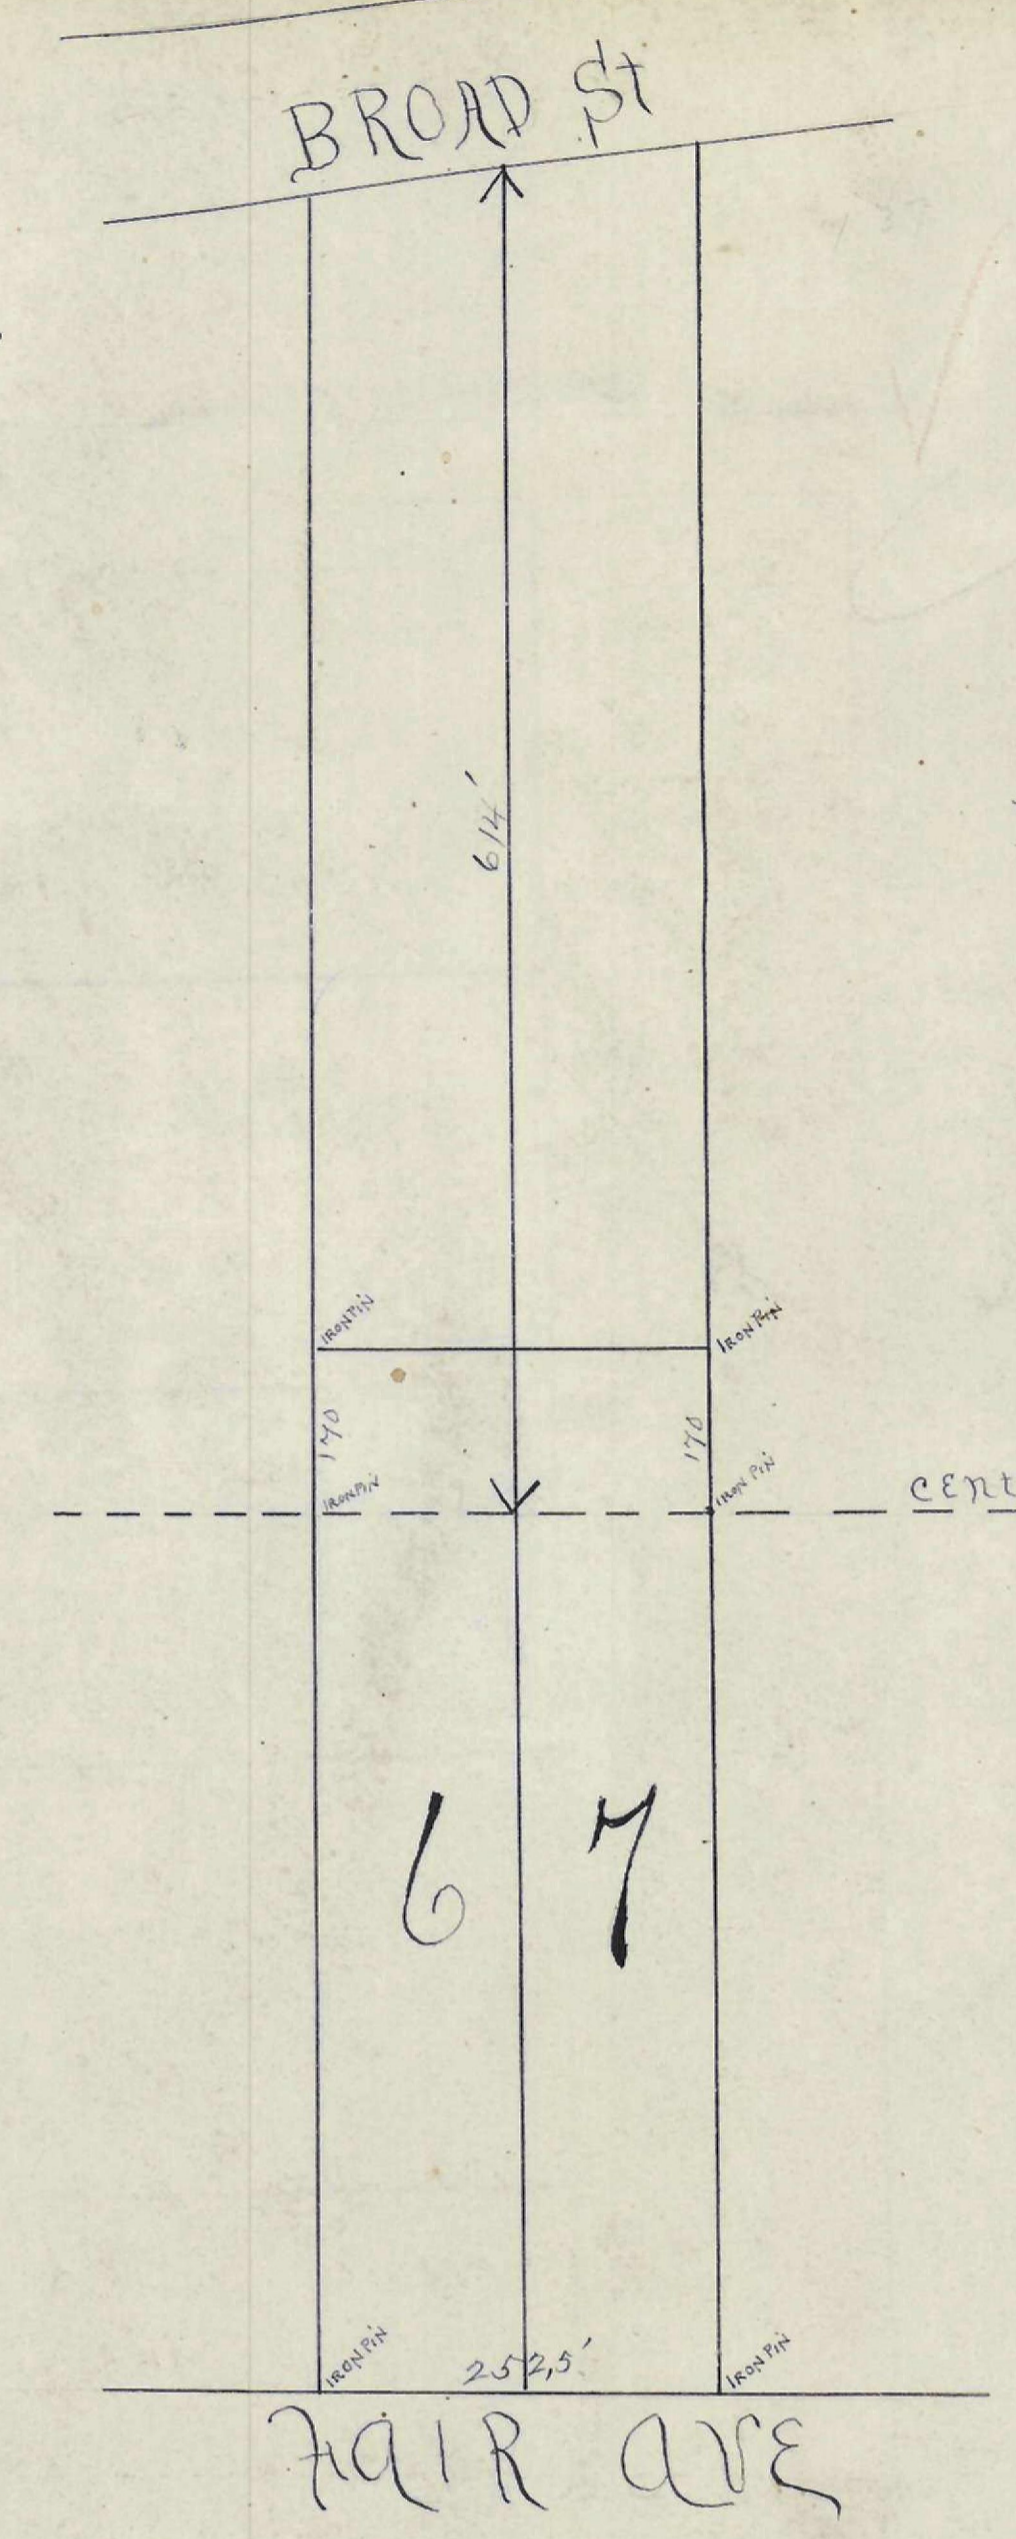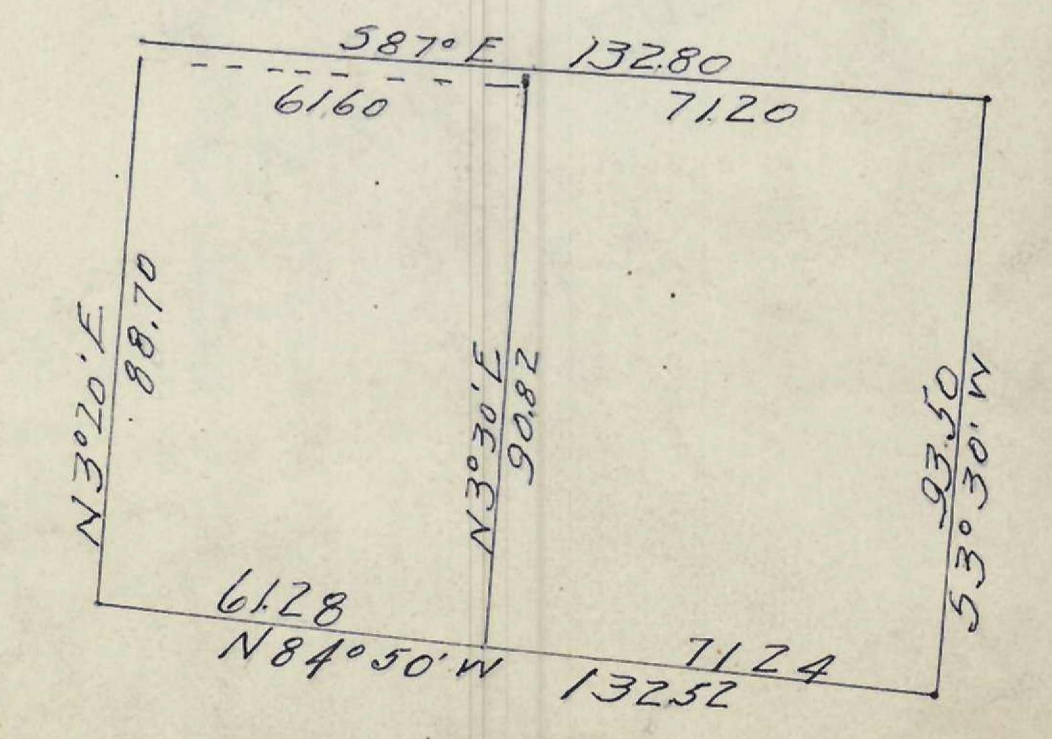

PLAT OF LAND surveyed for ADOLPH HAAK
 Being the south part of Lots 6 & 7 of Sam Barker's Subdivision
 J.F. Durr County Surveyor for E.E. Long
 Recorded in Plat Book 1 Page 6
