


1890 FEB 22 1890

PLAT
OF
MERZ AND HENDRON LAND
 in Seaco Township.
 Surveyed Feb. 6, 1890, by J.D. Dun Co. Sur.
 MARK per E. B. Legg. Ant. Eng.

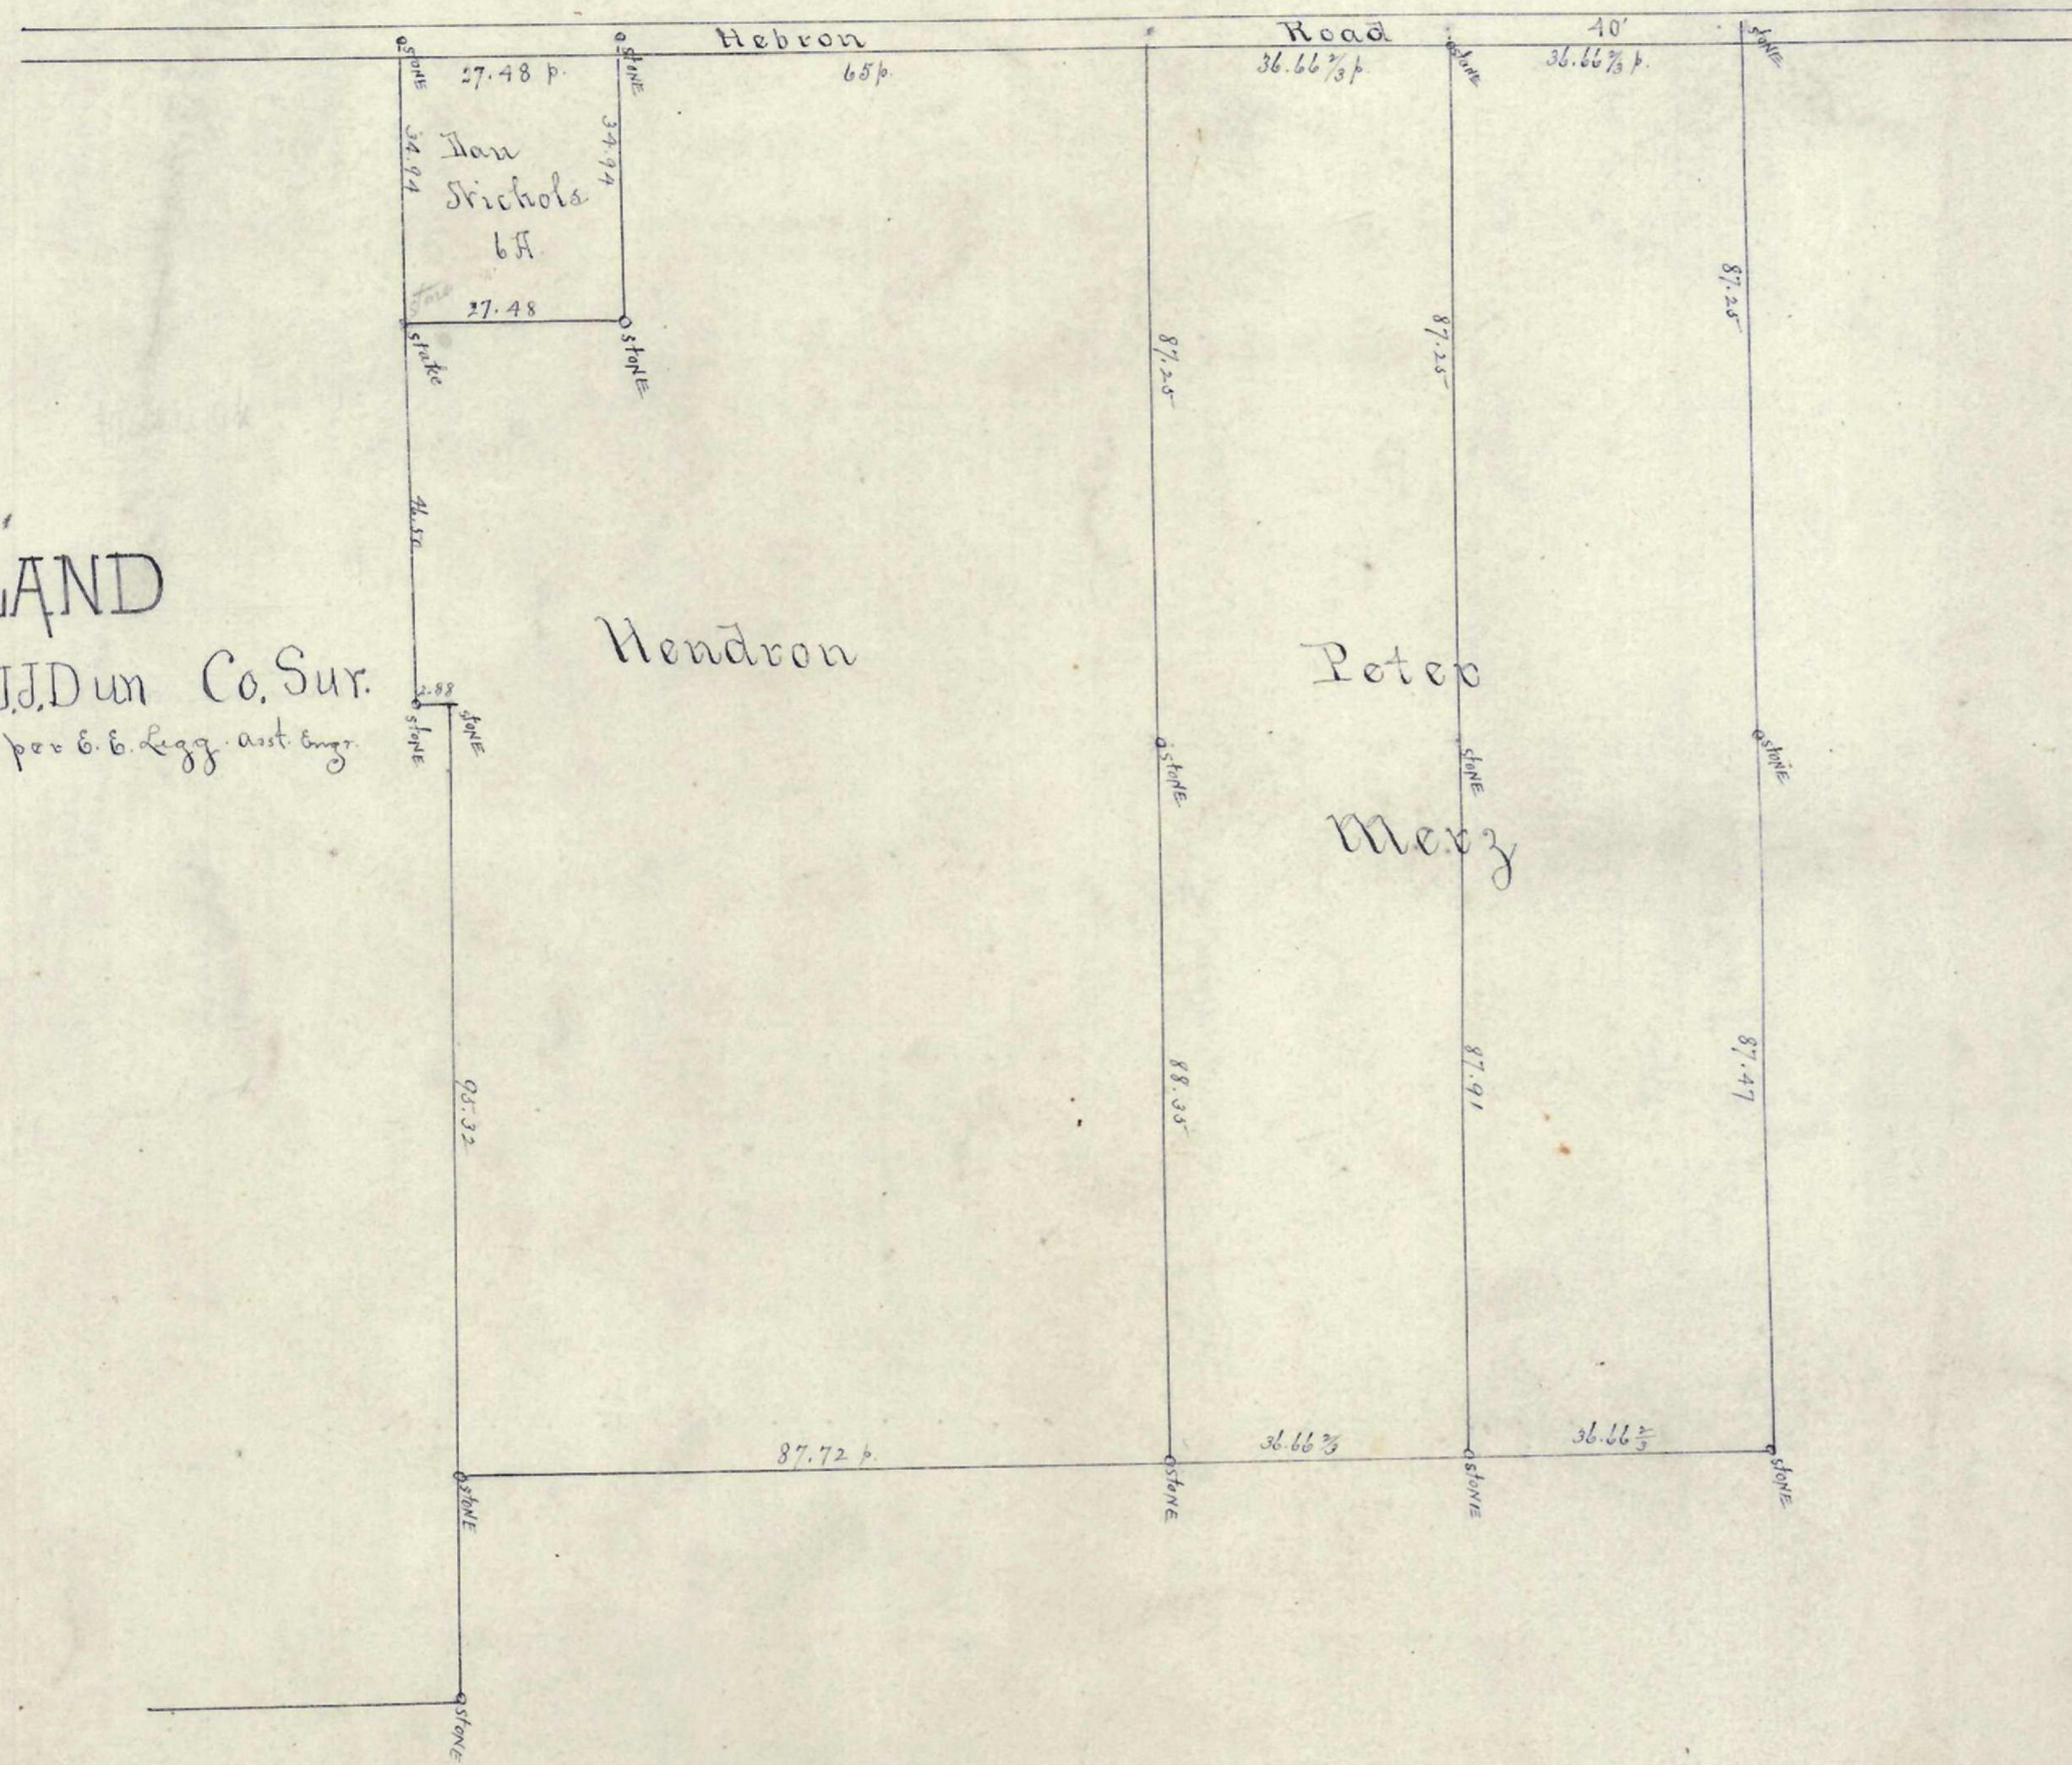


