


PLAT

CARL SMIDT LAND

Hamilton Tp


Surveyed Feb 10, 1890 by J.J. Dunn per E. Legg

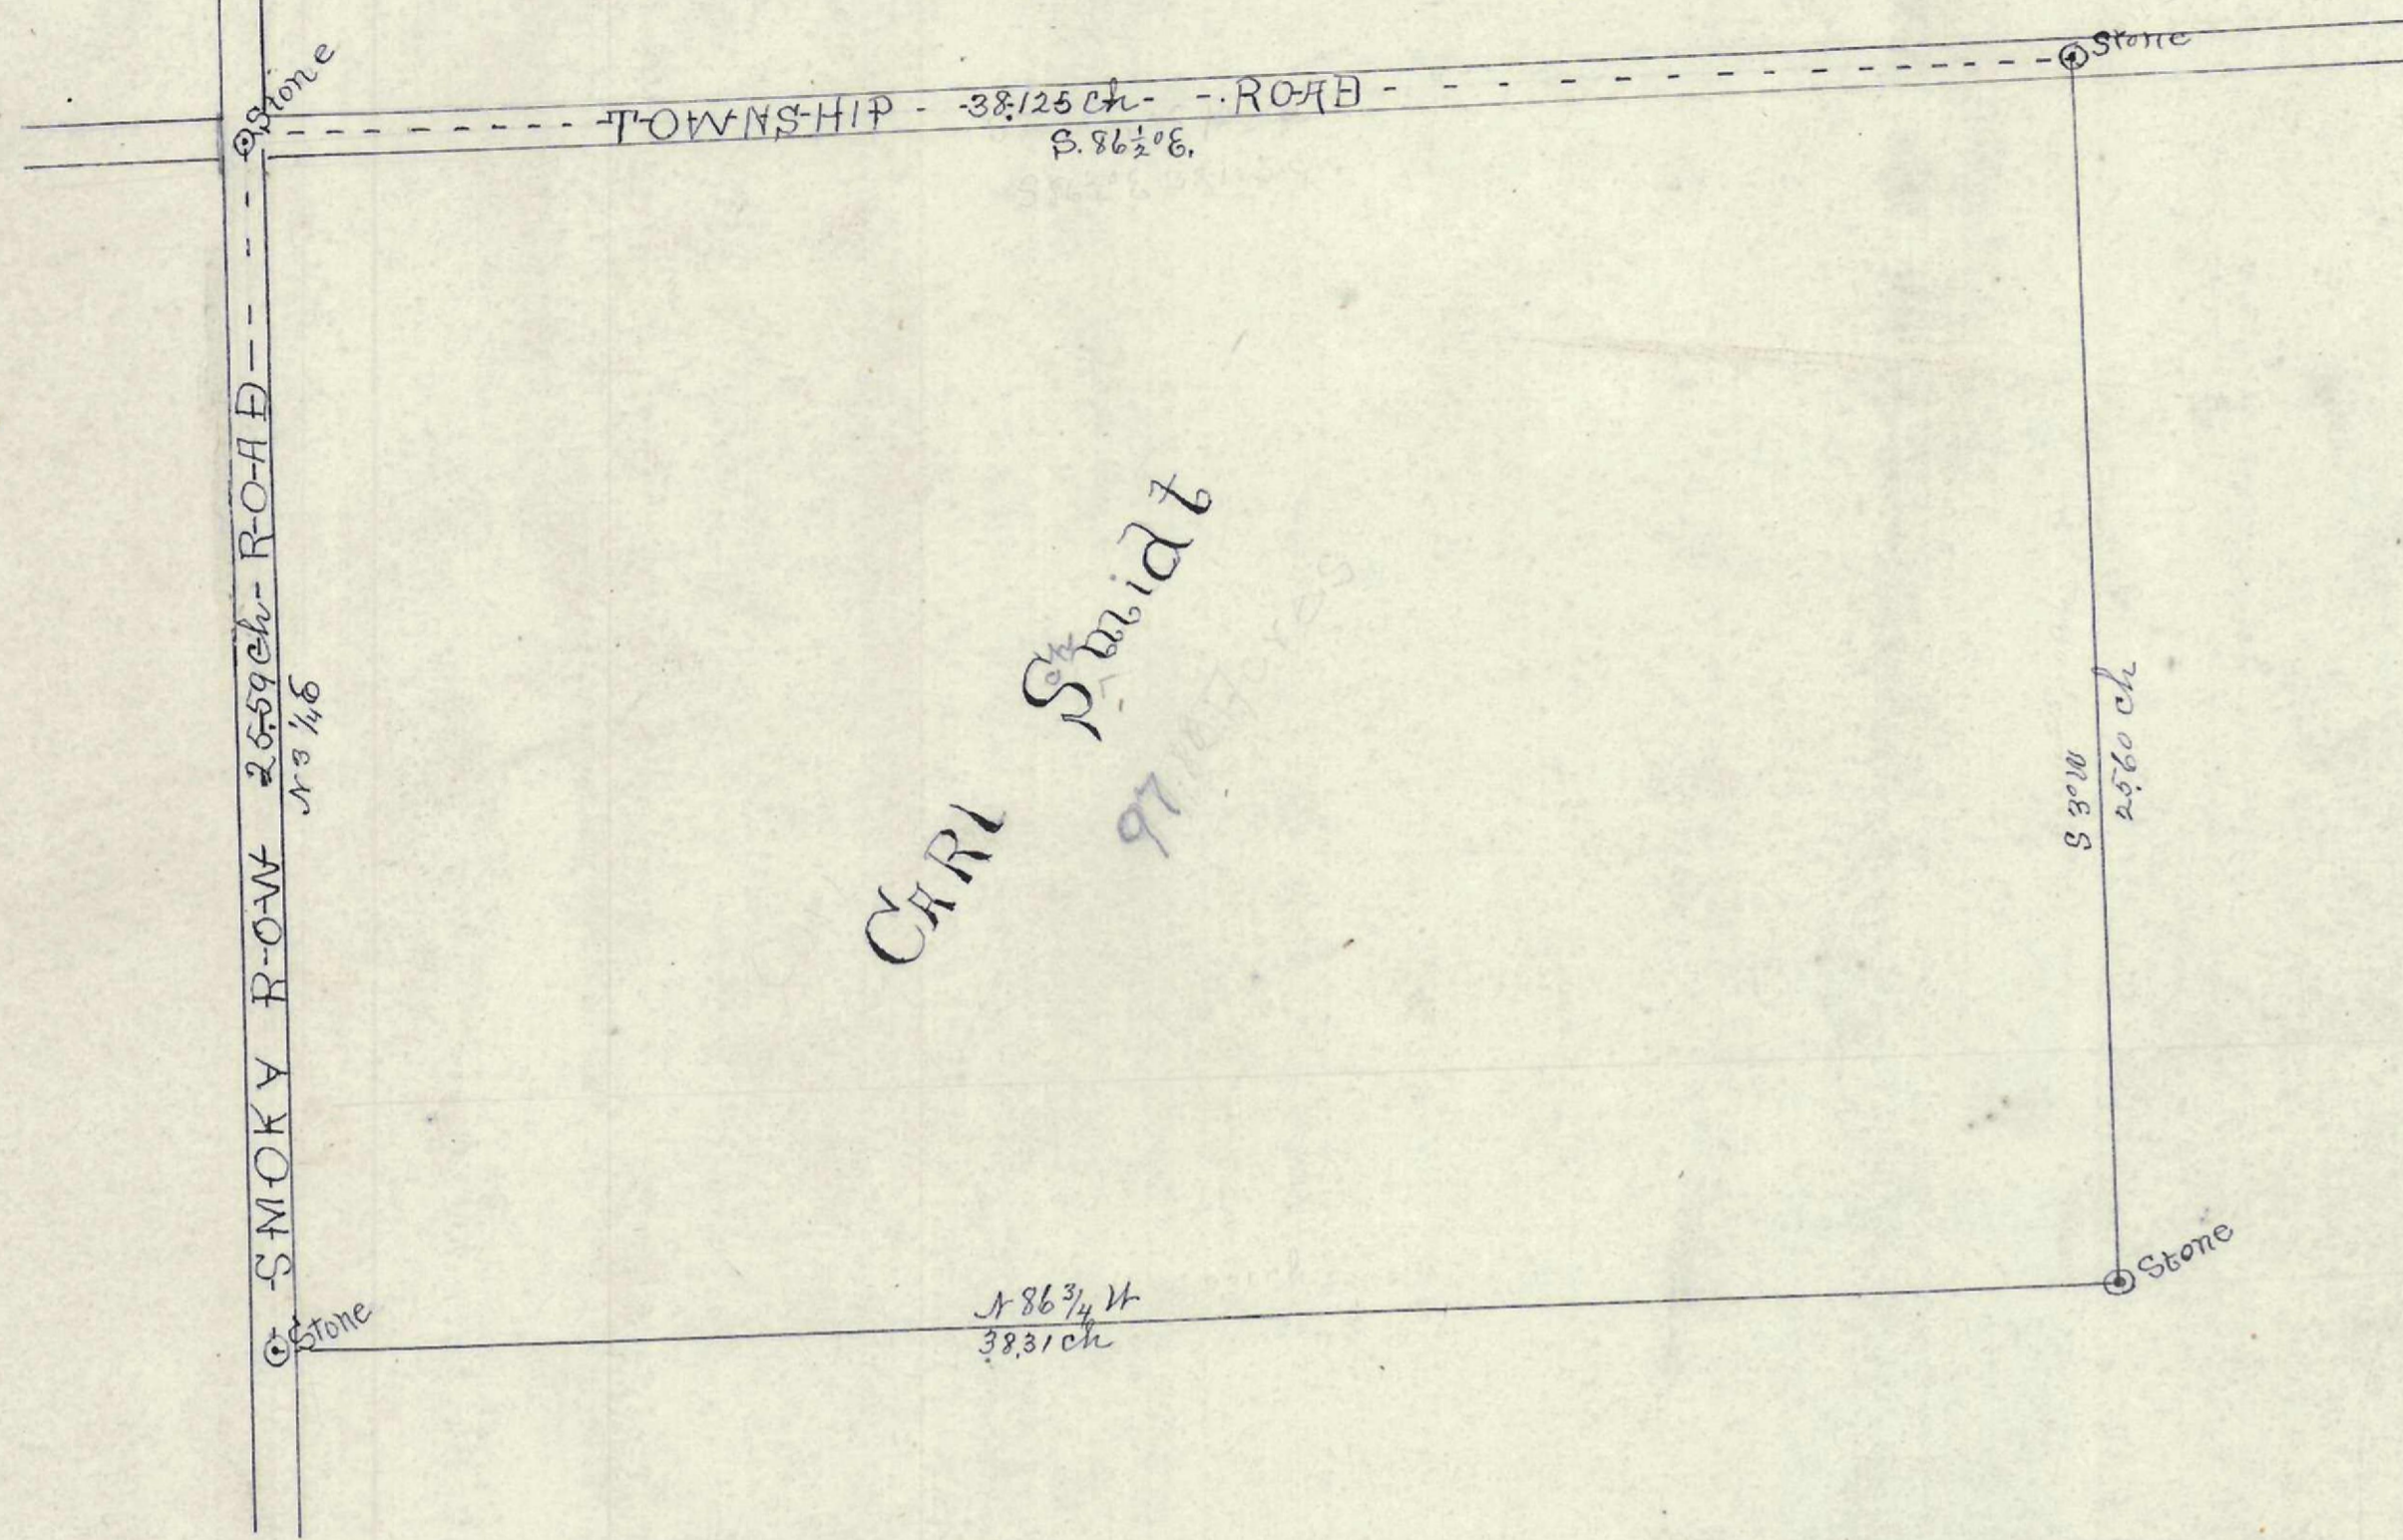

PLAT

John Warner Tract in Madison Tp.

Surveyed by J.J. Dunn, C.S. Jan 1890 per E. Legg

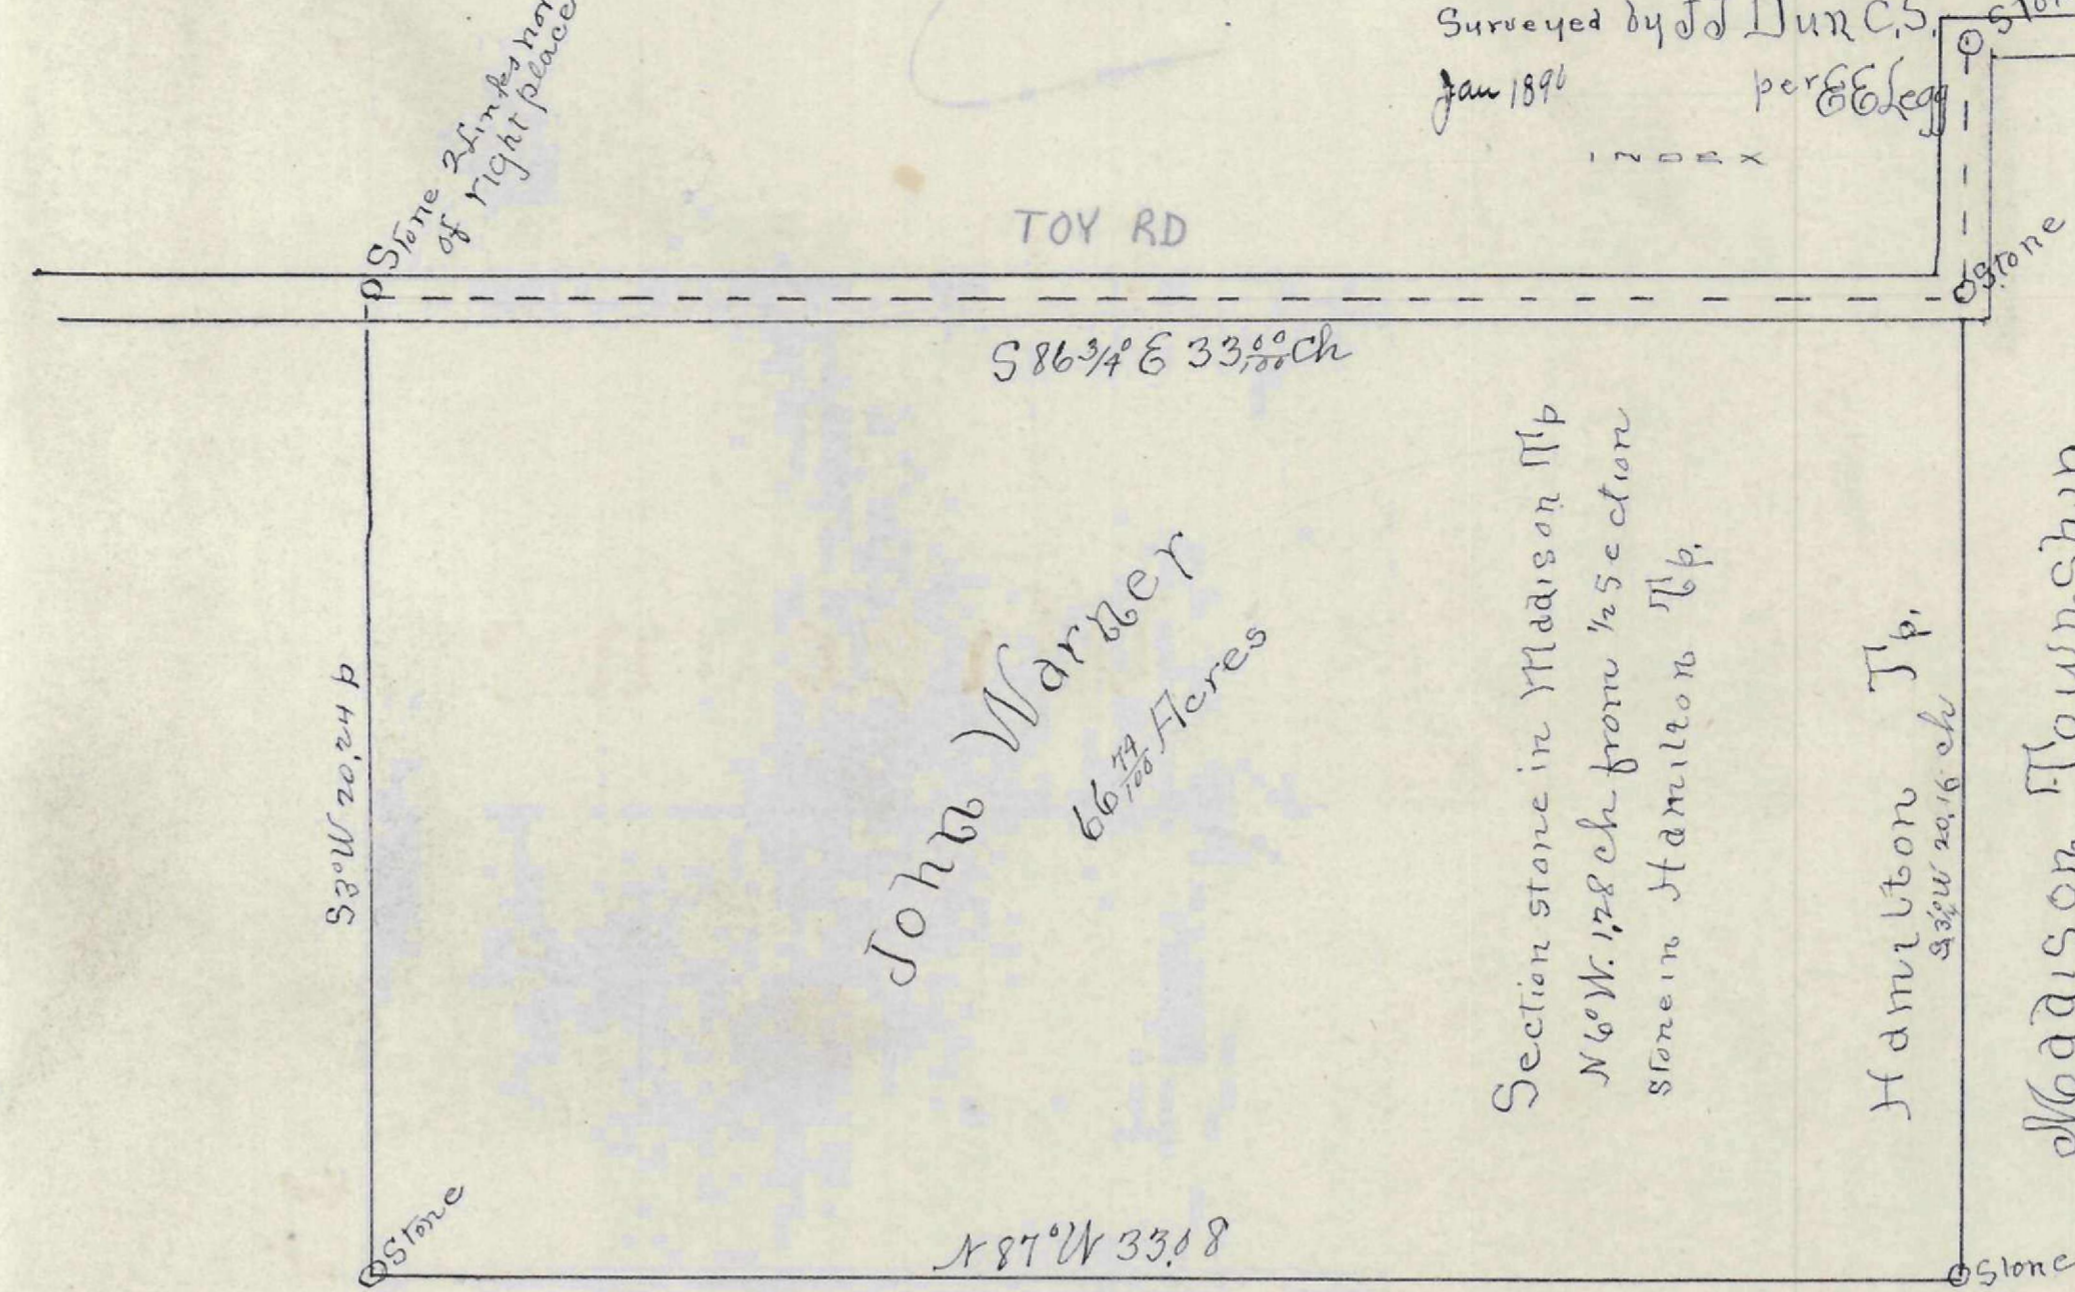


PLAT

SUSAN HERR LAND


Jan 11, 1890

Surveyed by J.J. Dunn C Surveyor Per E. Legg

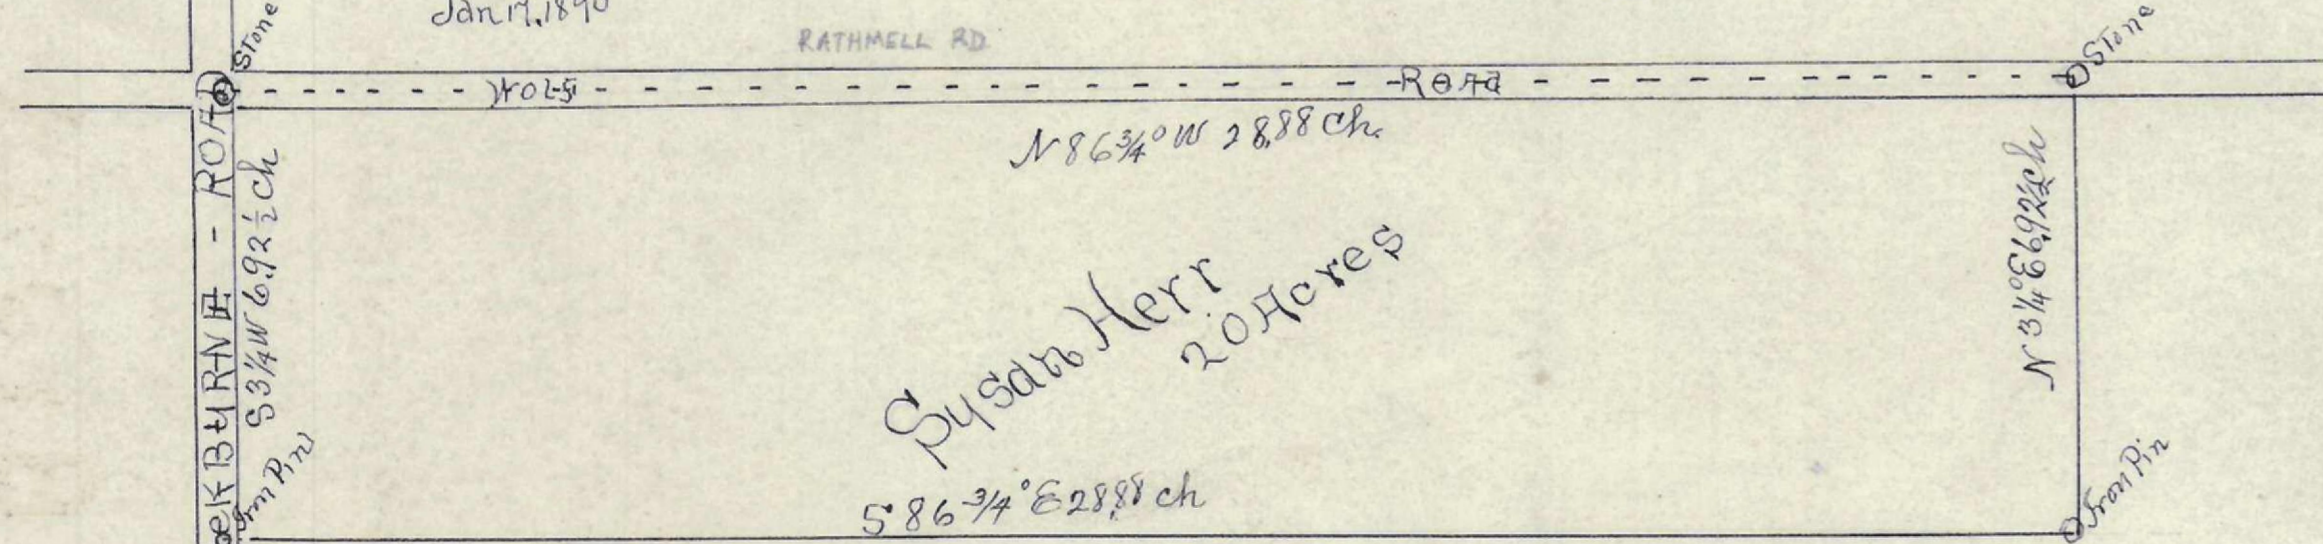

Plat

DRRus farm Hamilton Township Surveyed by E. Legg 1890

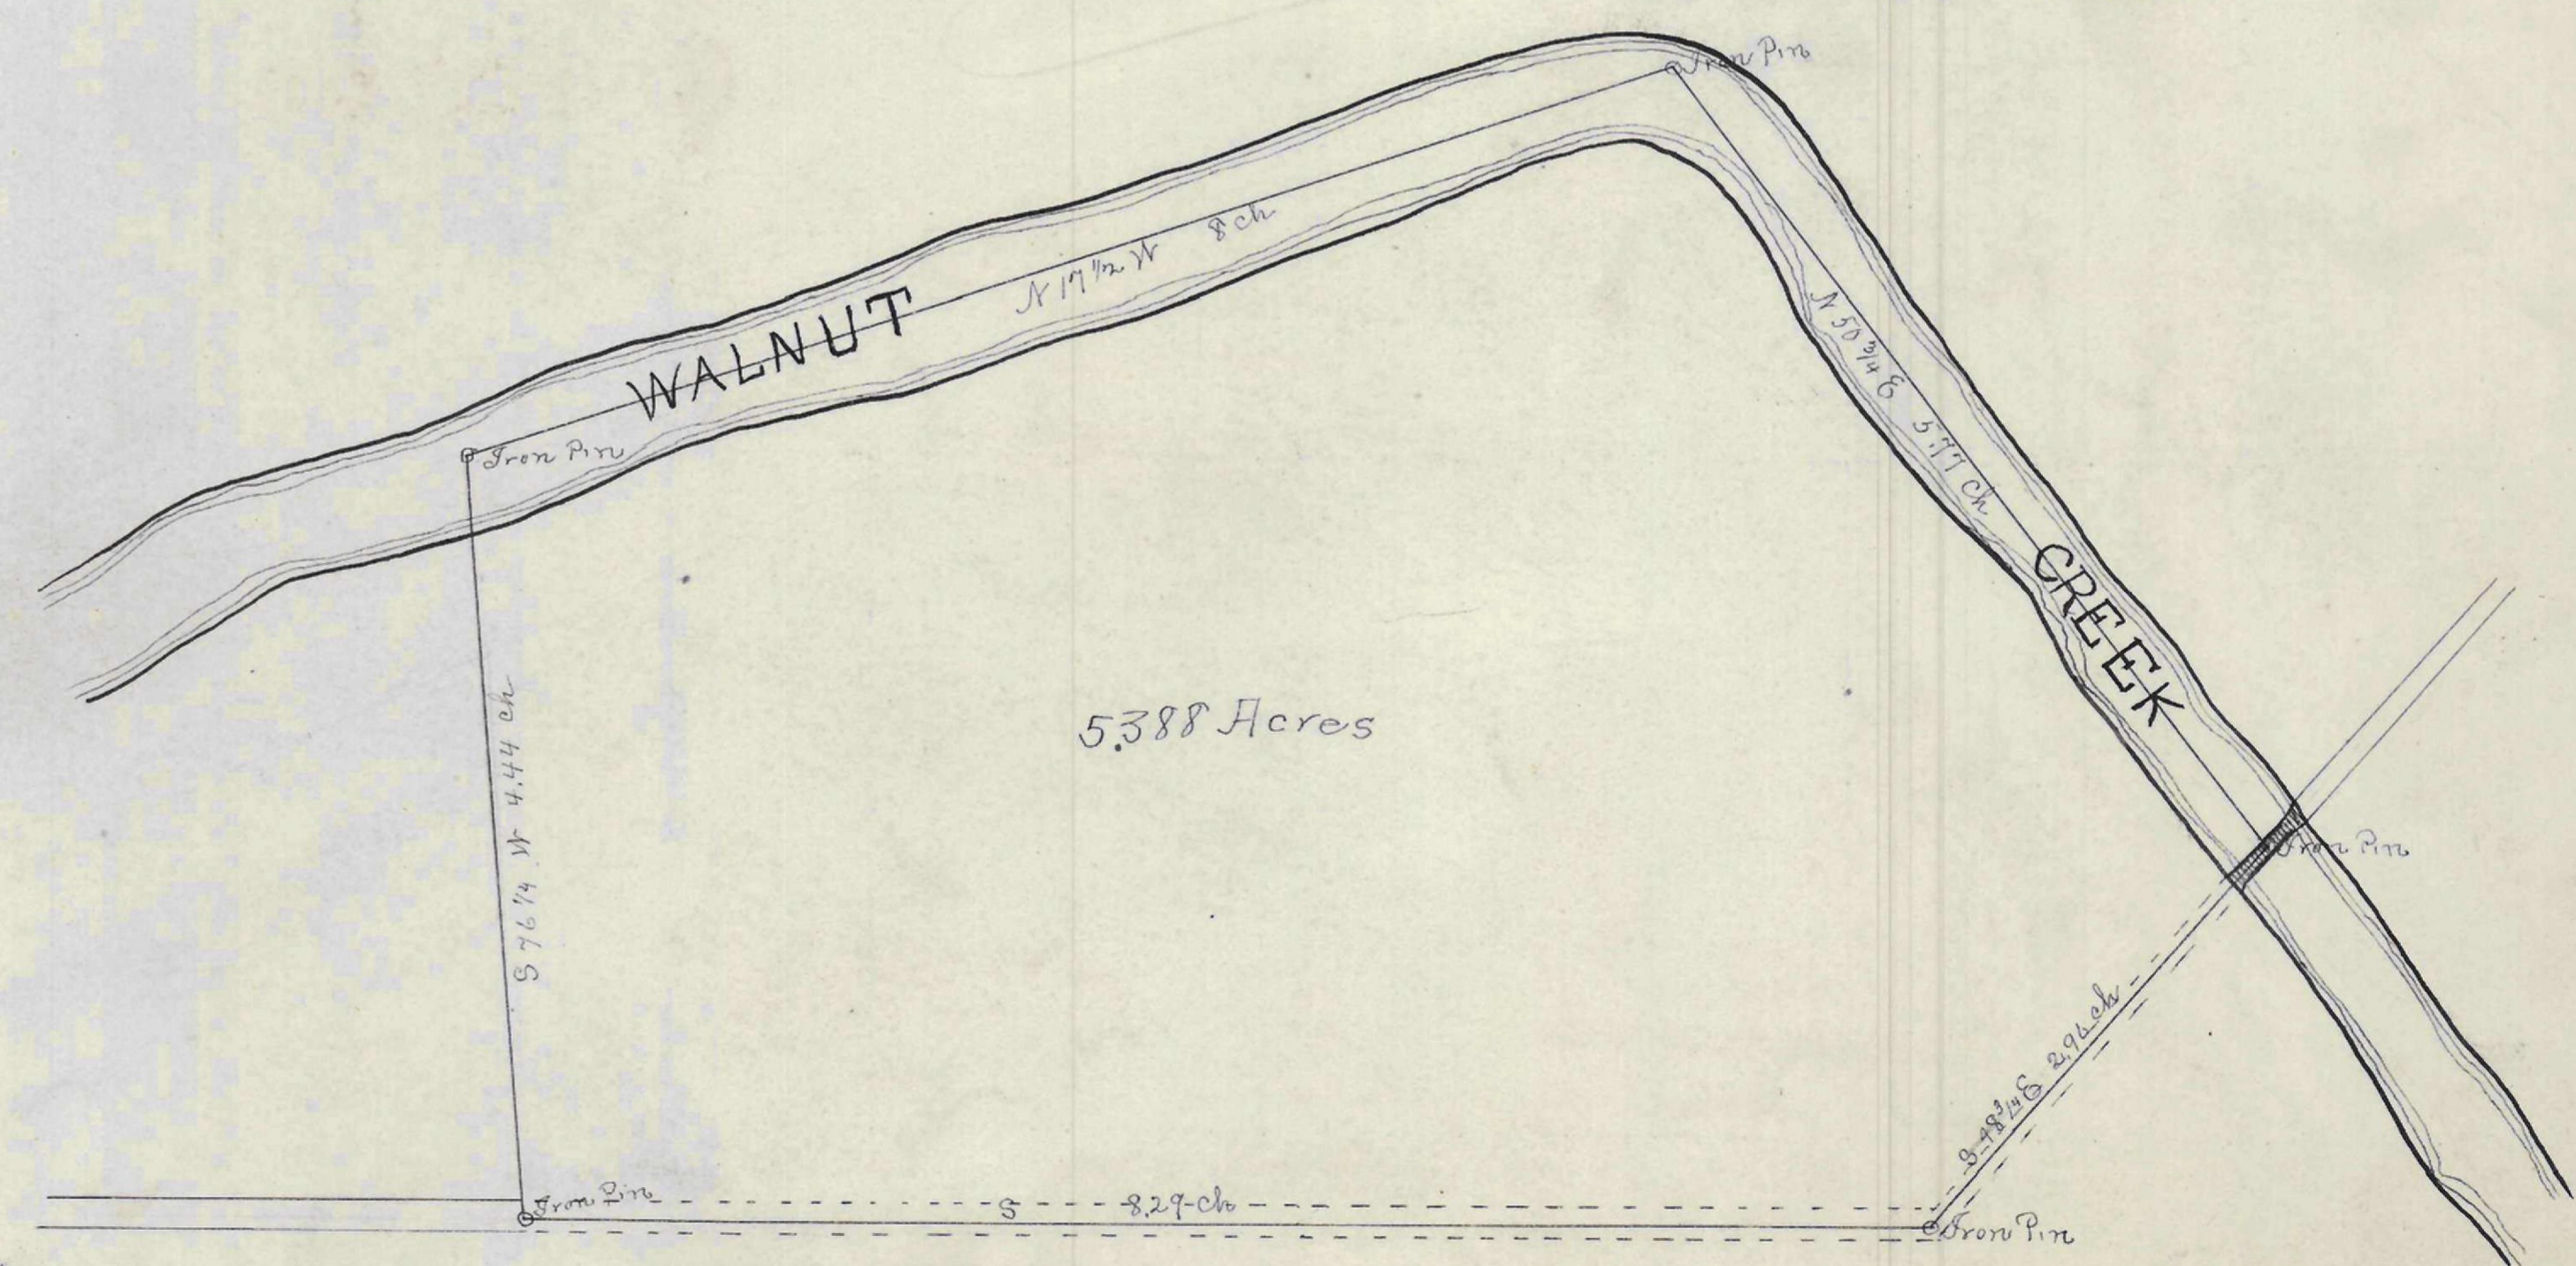

Plat

The Russ School lot

Jan 11, 1890

Surveyed by J.J. Dunn per E. Legg

