
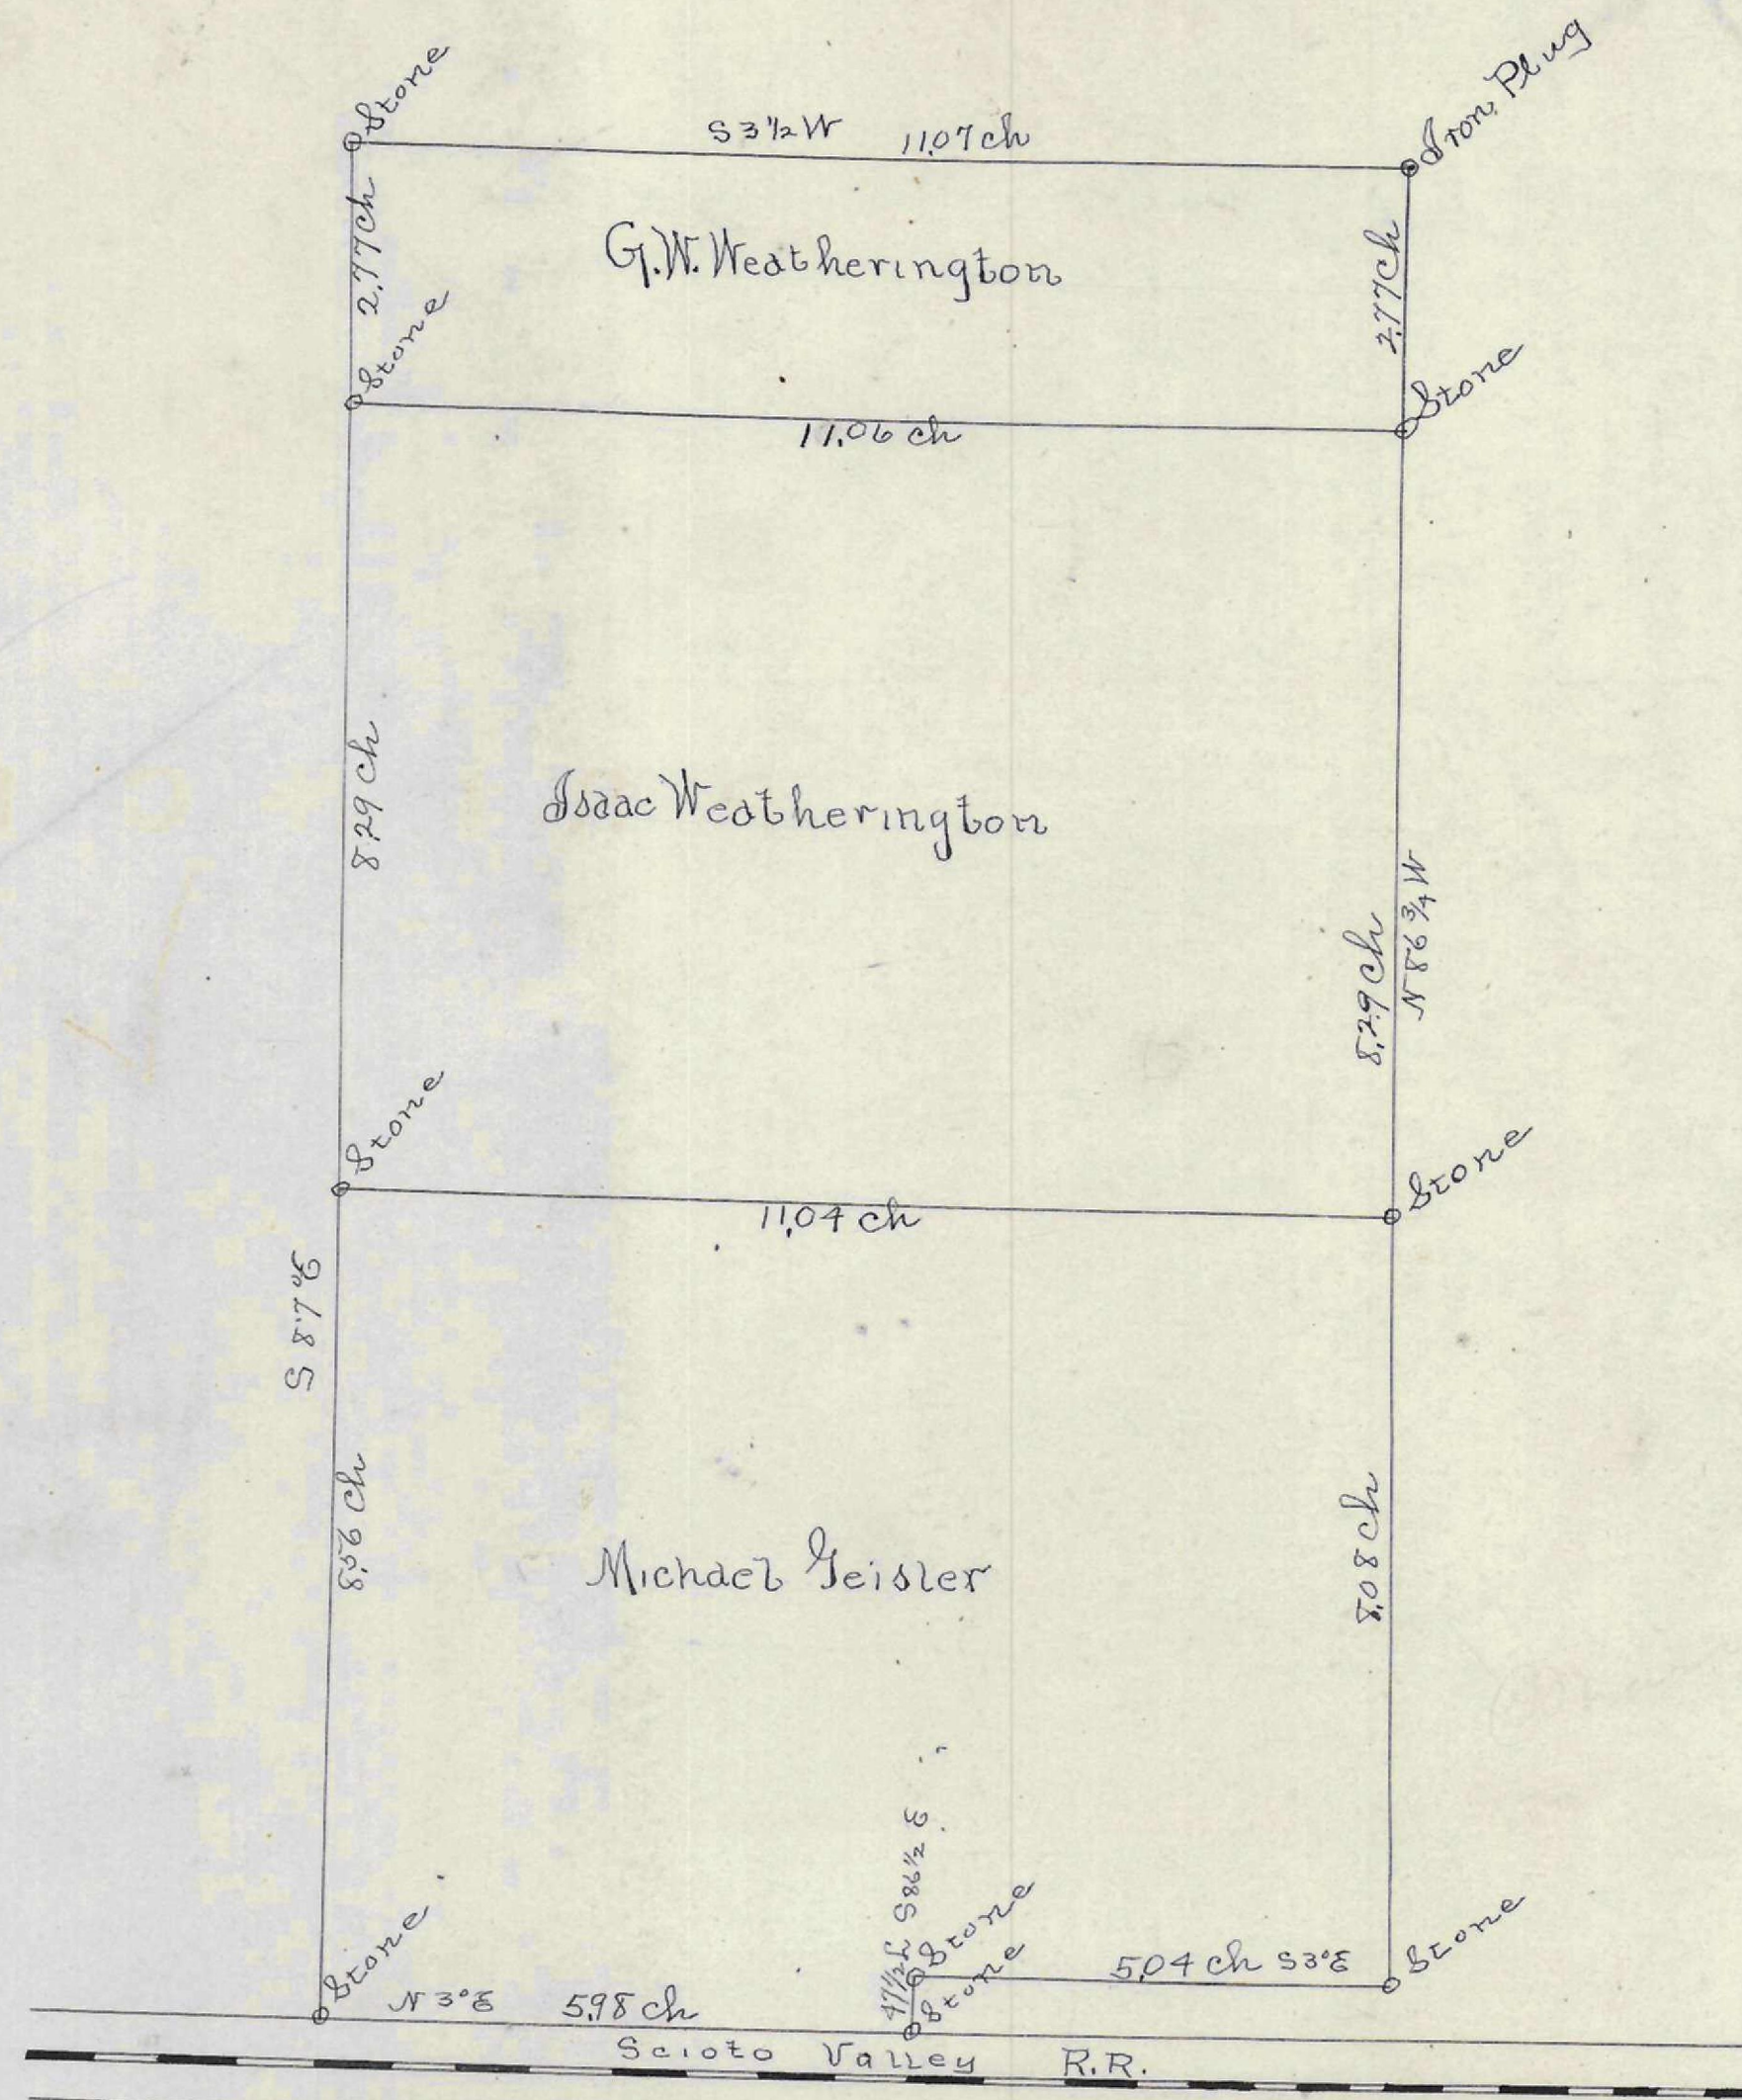




Plat

Of survey made for Geo. W. Brackenridge in Jackson Township Franklin Co. O.
Surveyed by John J. Linn March 16 1890
per W. Brown.

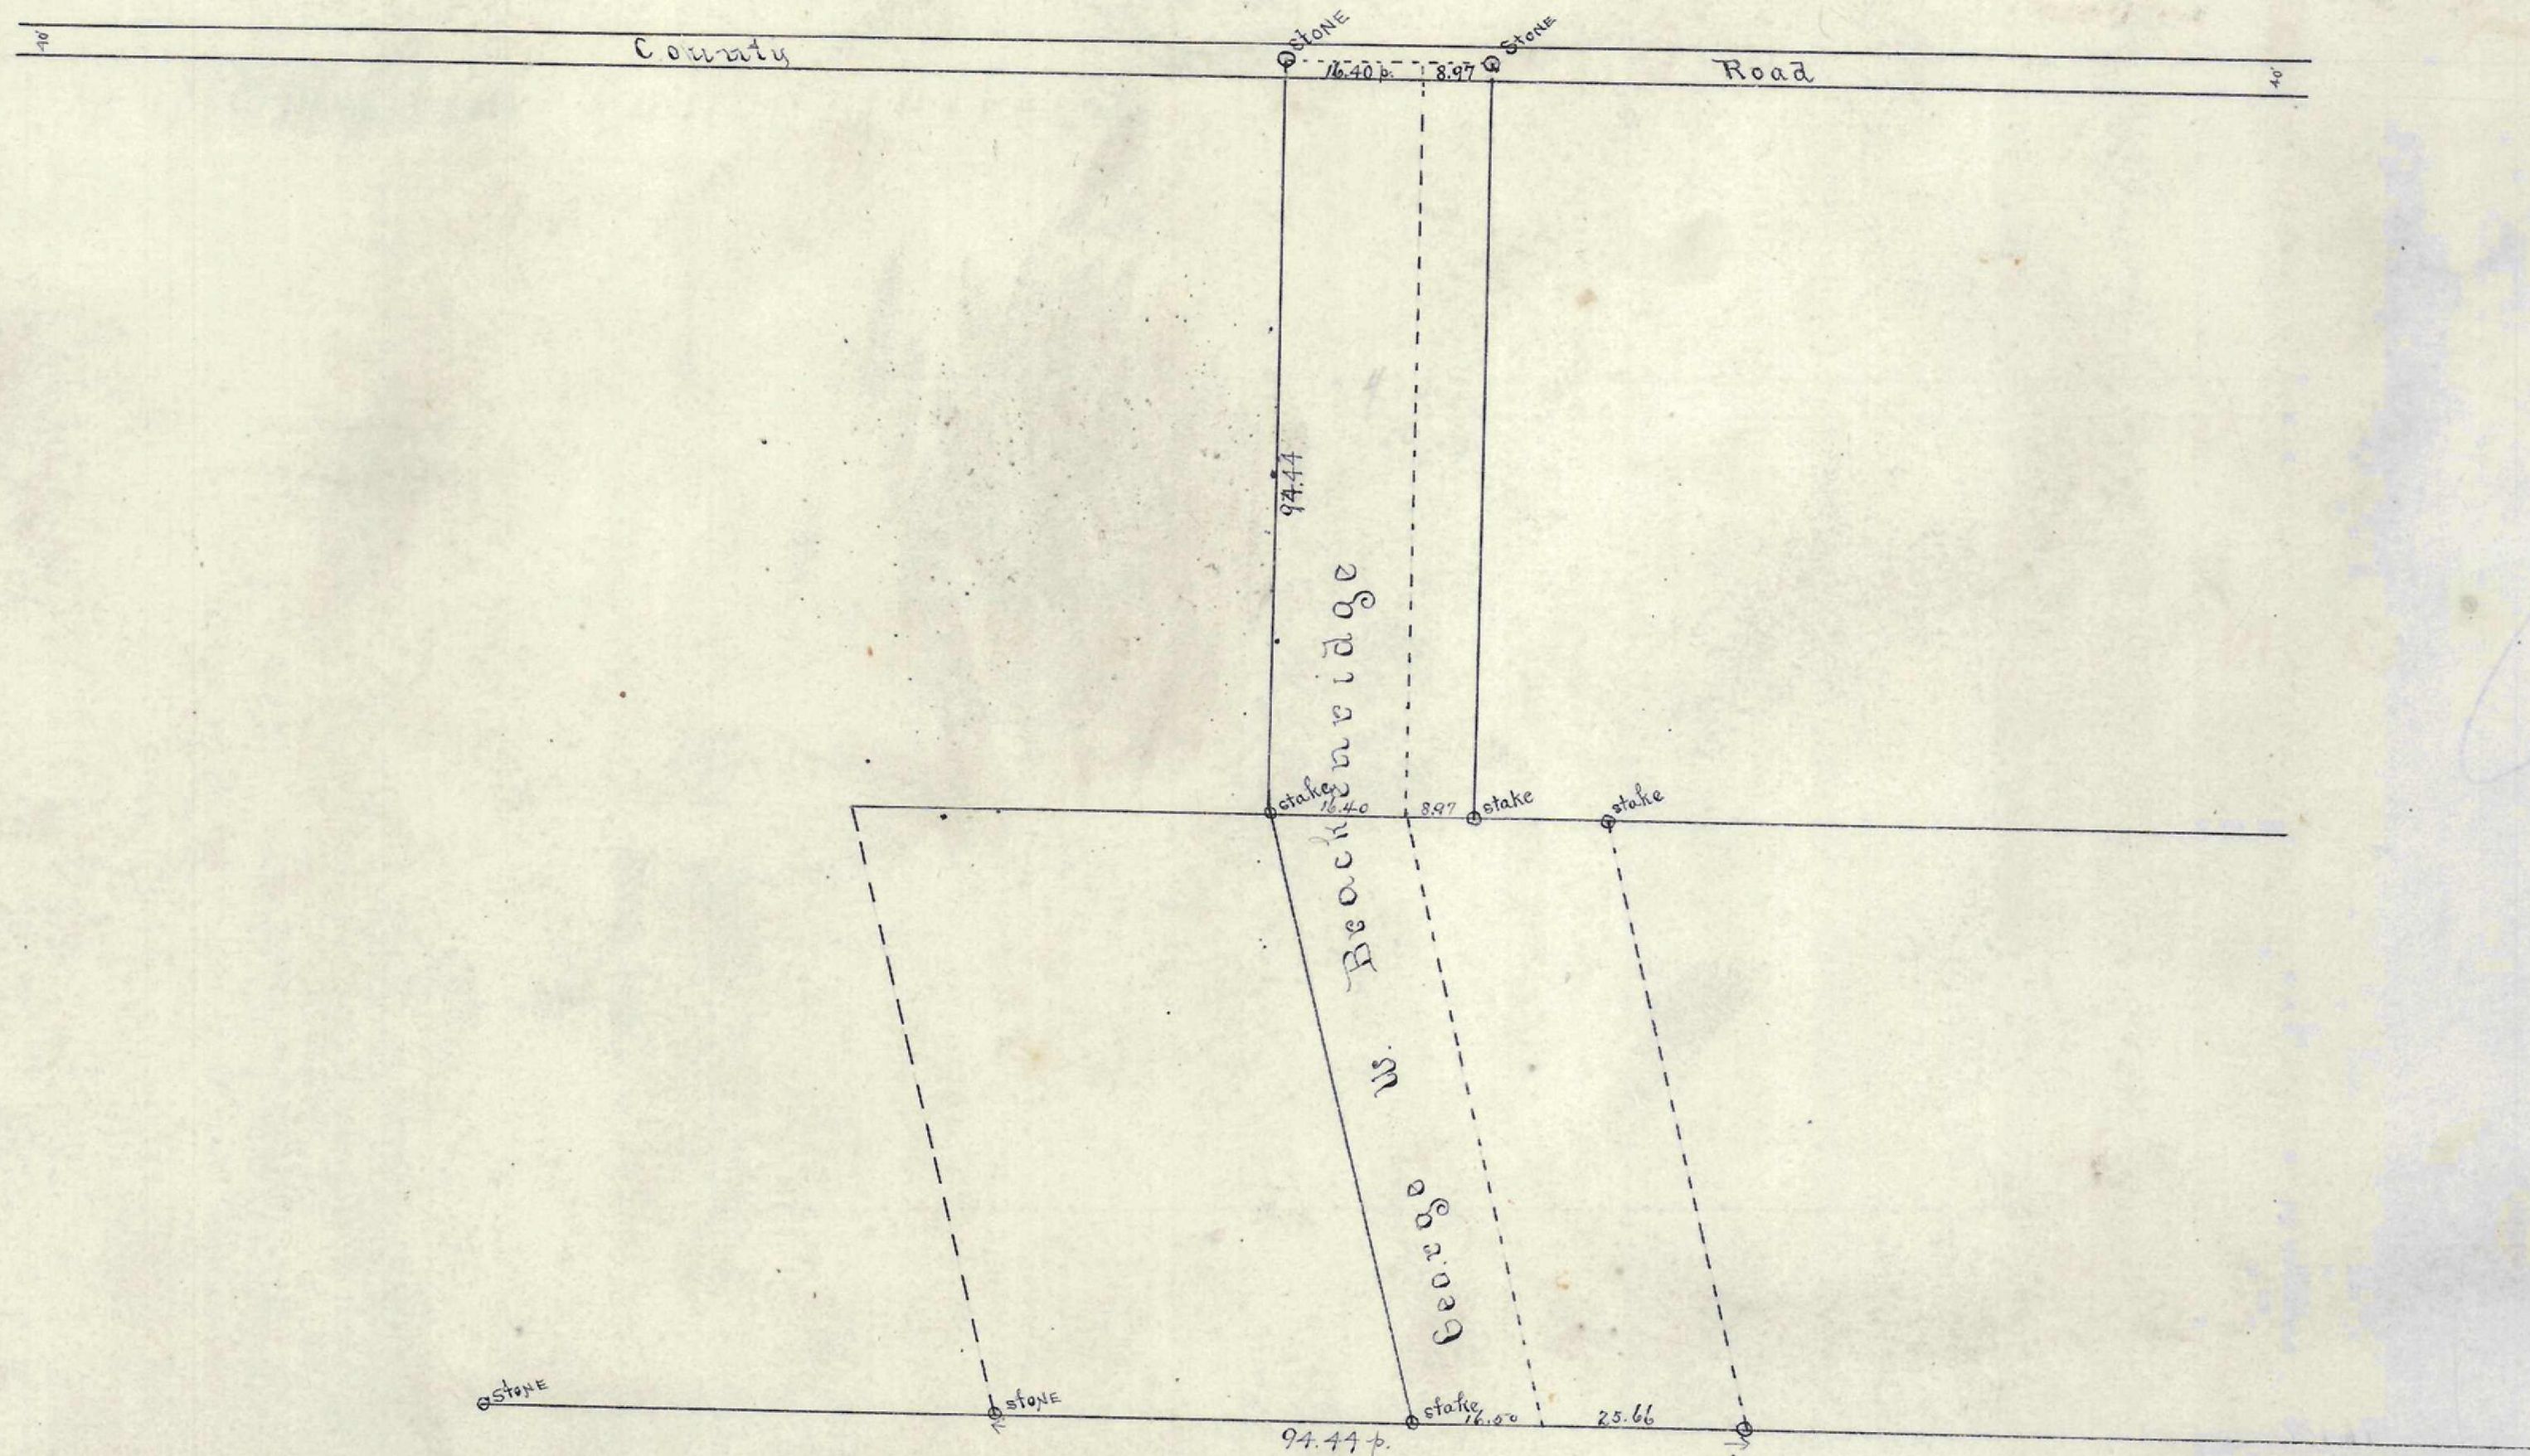

PLAT OF

Lot Surveyed in Thos. Miller's Heirs Subdivisions.
Surveyed Aug 23 1890
By H. Schupp & Co.

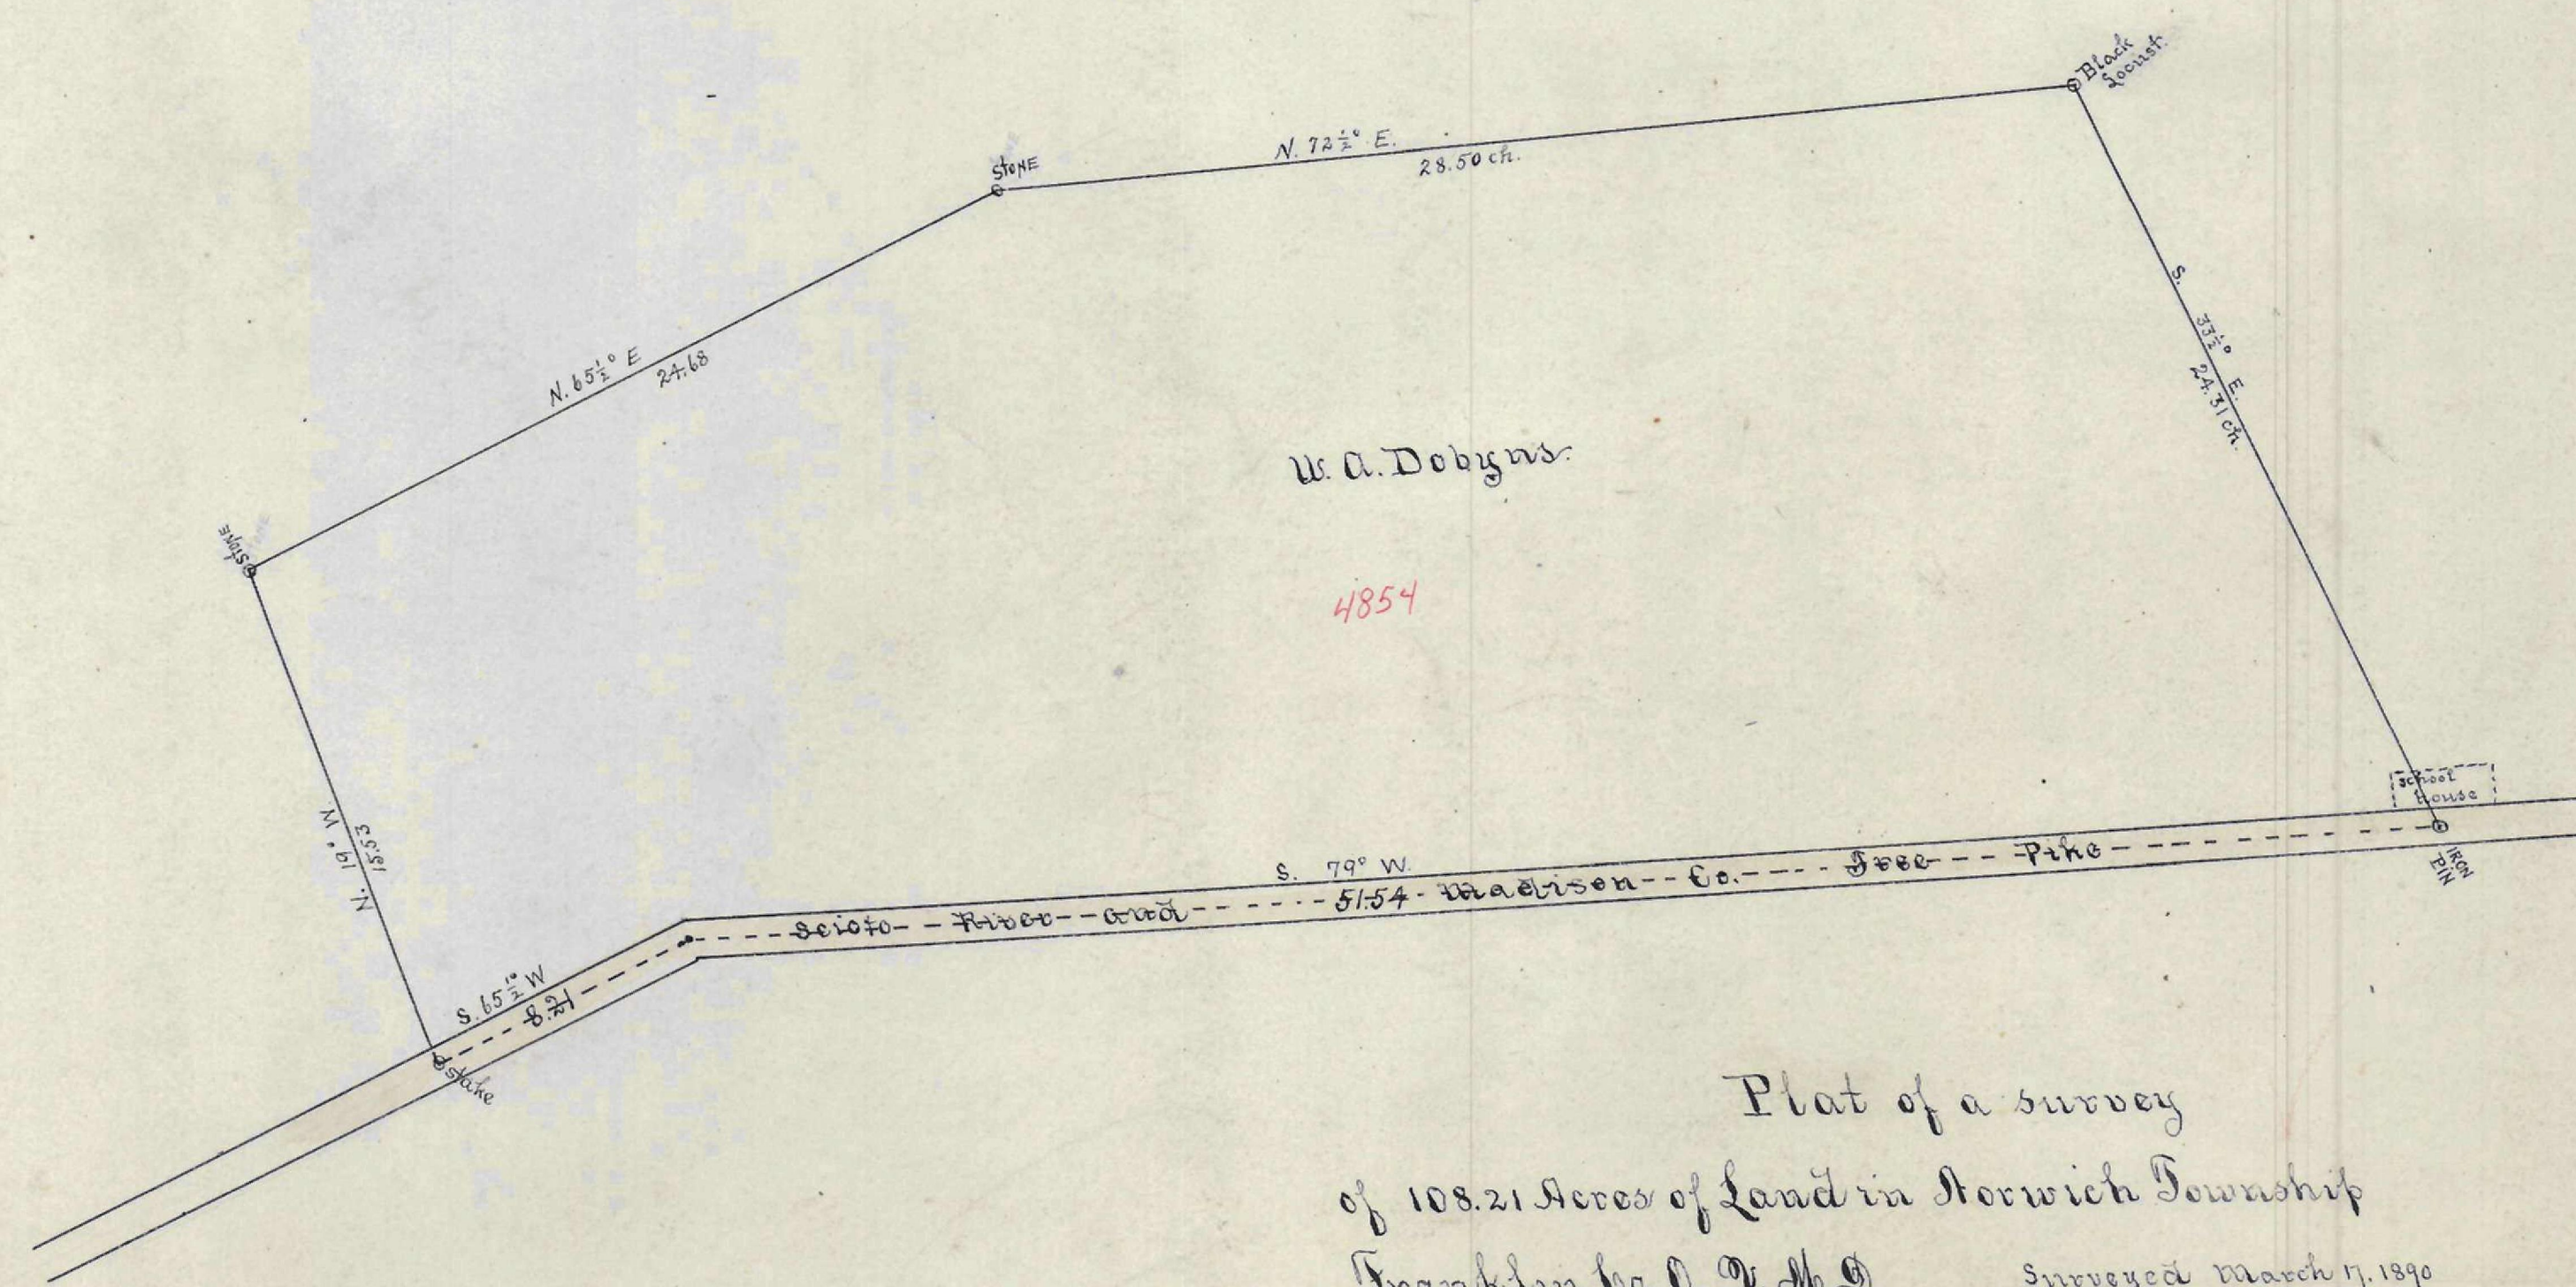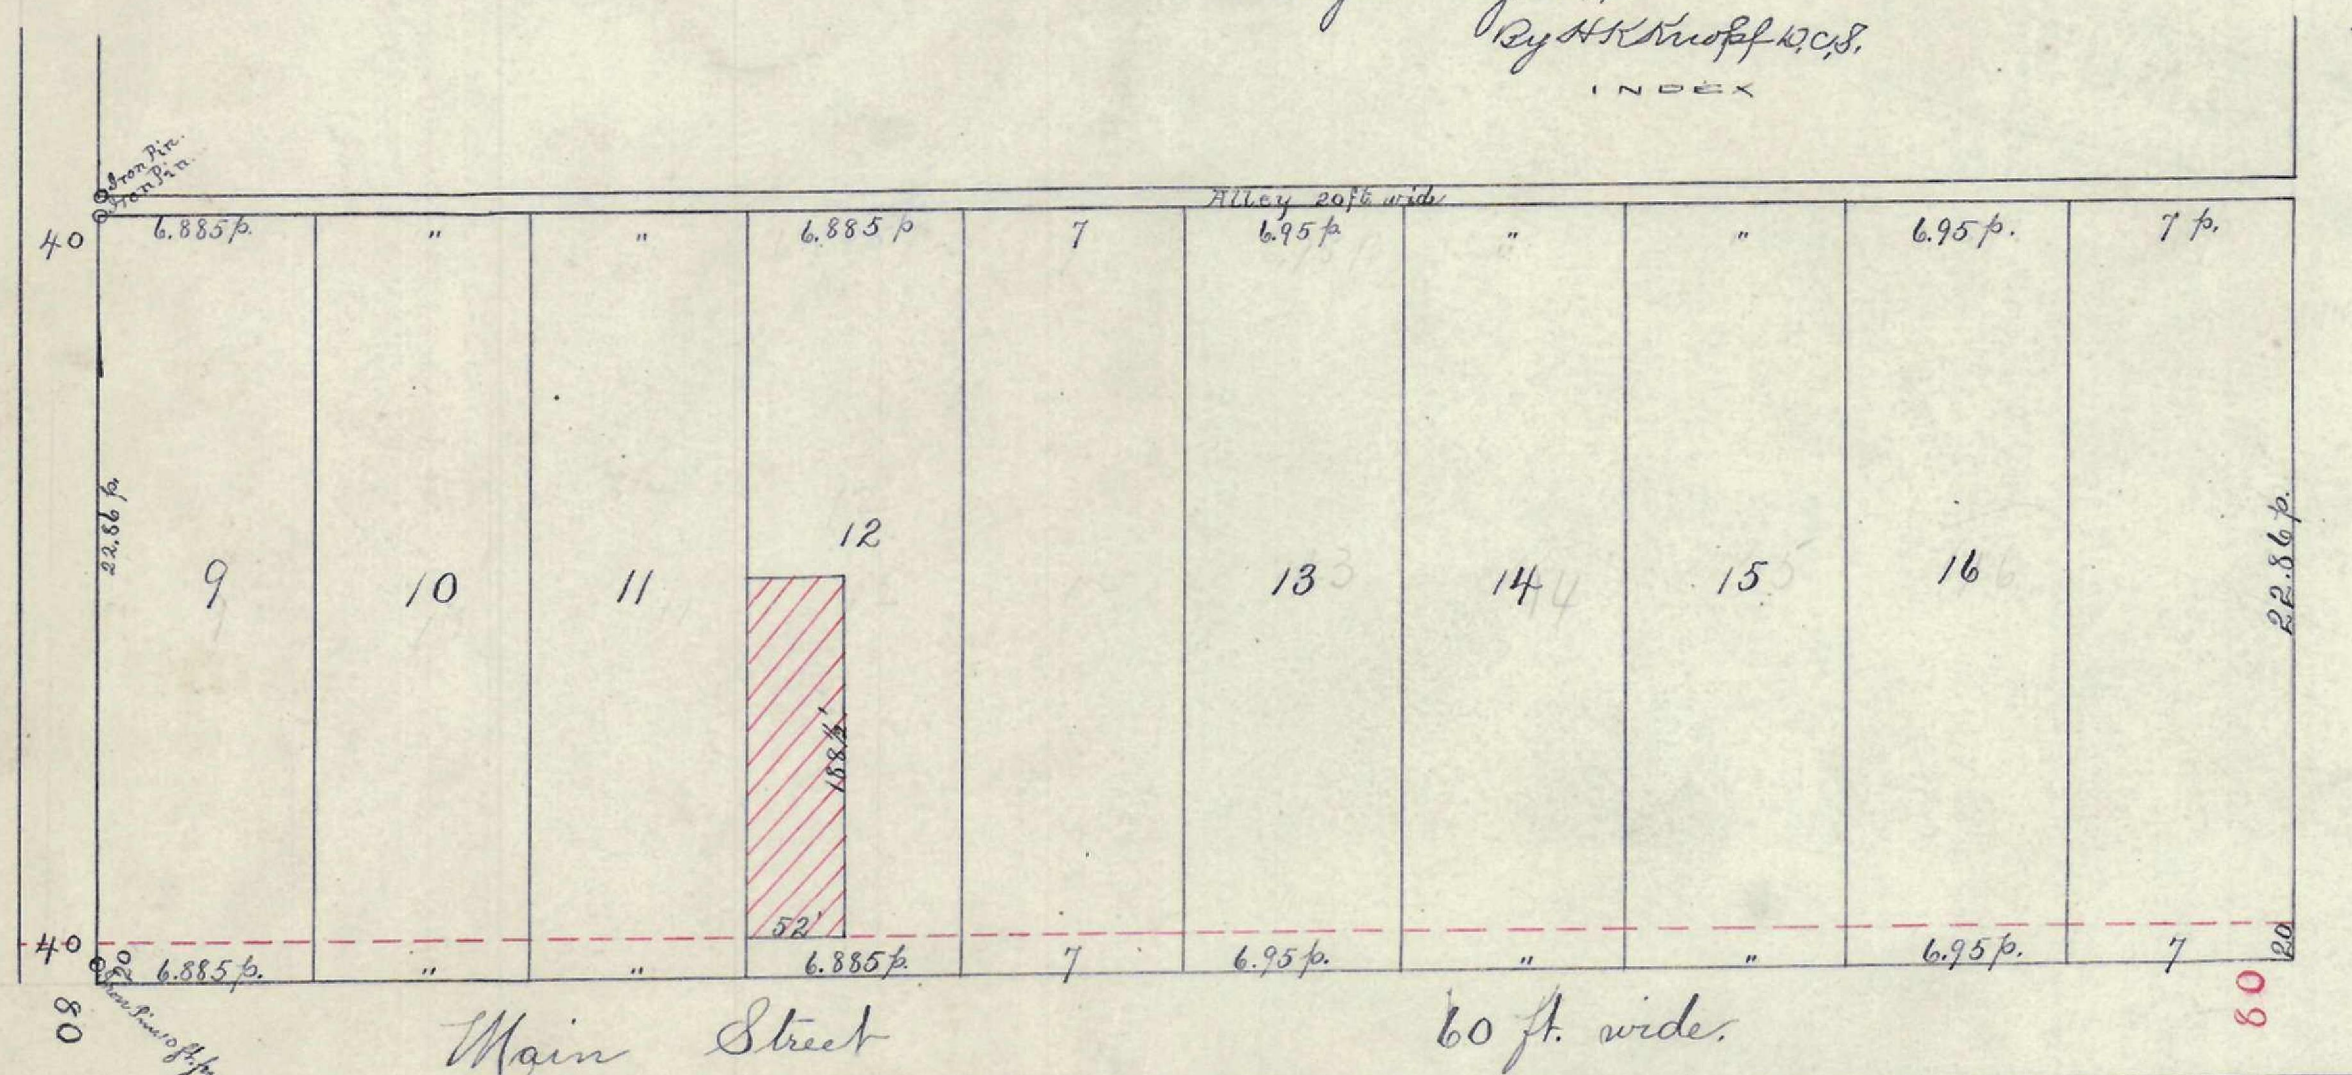

Plat of a survey
