139

PLAT OF
WILLIAMS TRACT Marion Tp Franklin Co O
Surveyed by E F Kelsey D.C.S.
OCT 19/90
INDEX

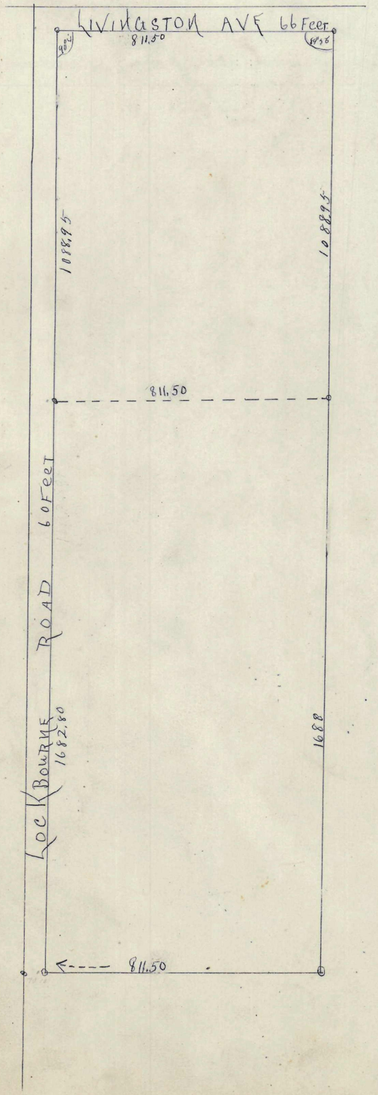

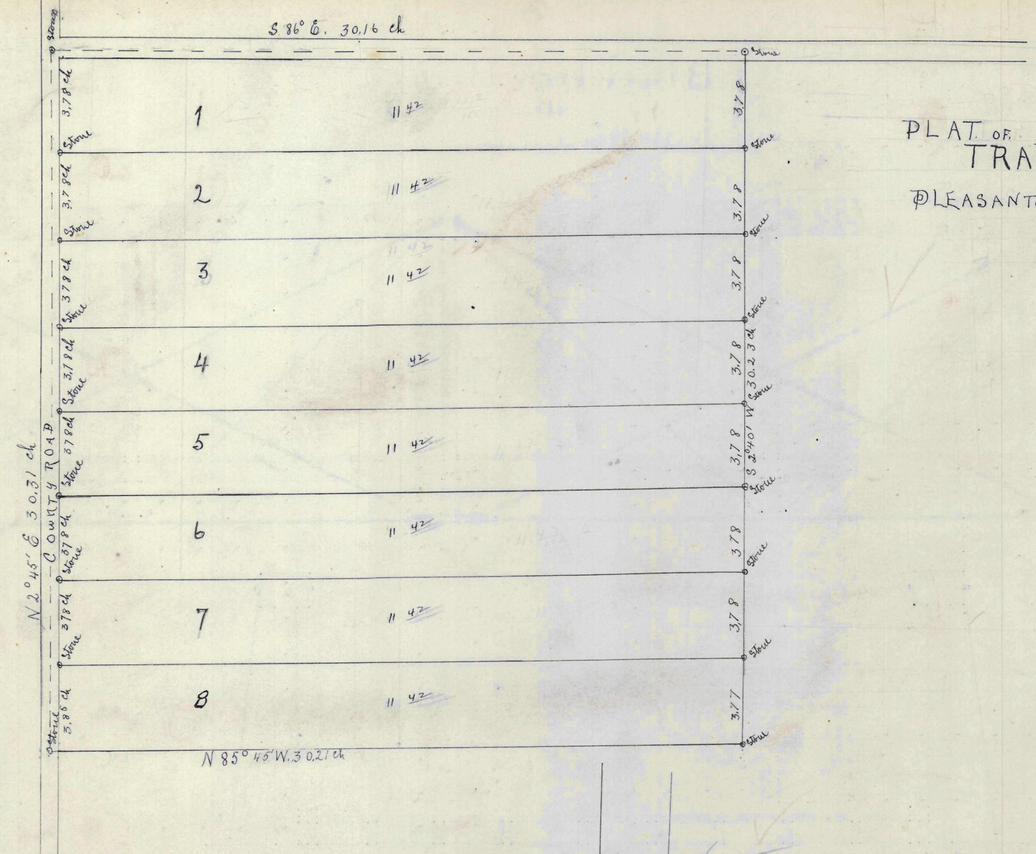

PLAT OF
TRAPP FARM.
PLEASANT TOWNSHIP.
FRANKLIN COUNTY. O.
SURVEYED BY.
H. K. KNOPF. DEPUTY CO. SURVEYOR.
DECEMBER. 16 & 17. 1890.
INDEX

Plat of lot surveyed for Judge Williams
Oct 1890

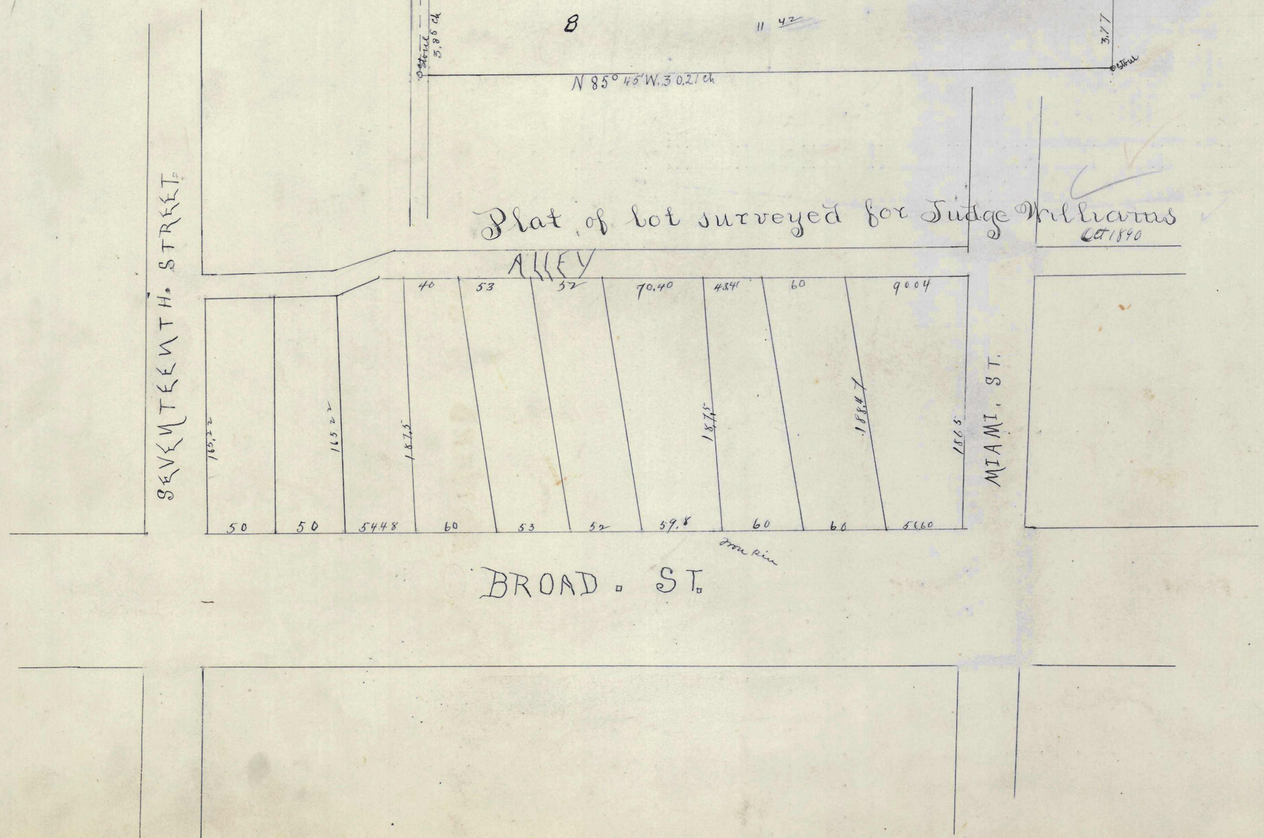
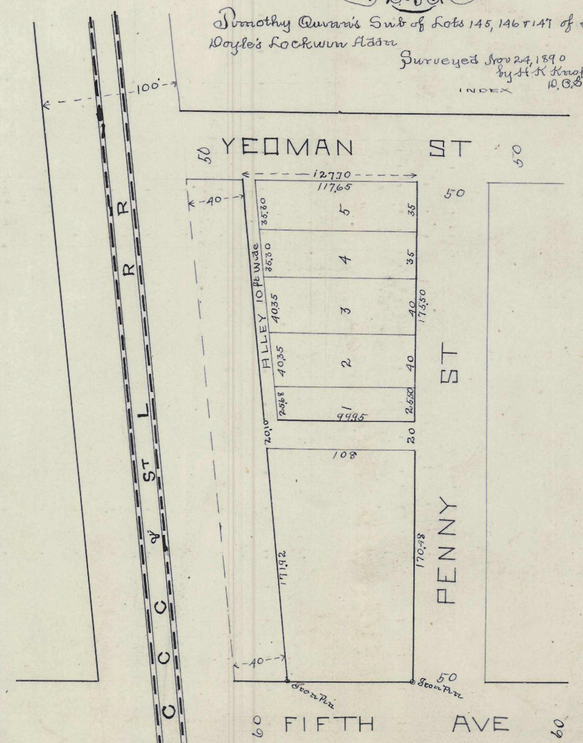
PLAT
of
Timothy Quinn's Sub of Lots 145, 146 & 147 of Sam'l Doyle's Lockwin Addn
Surveyed Nov 24, 1890
by H. K. Knopf
C.C.S.
INDEX