

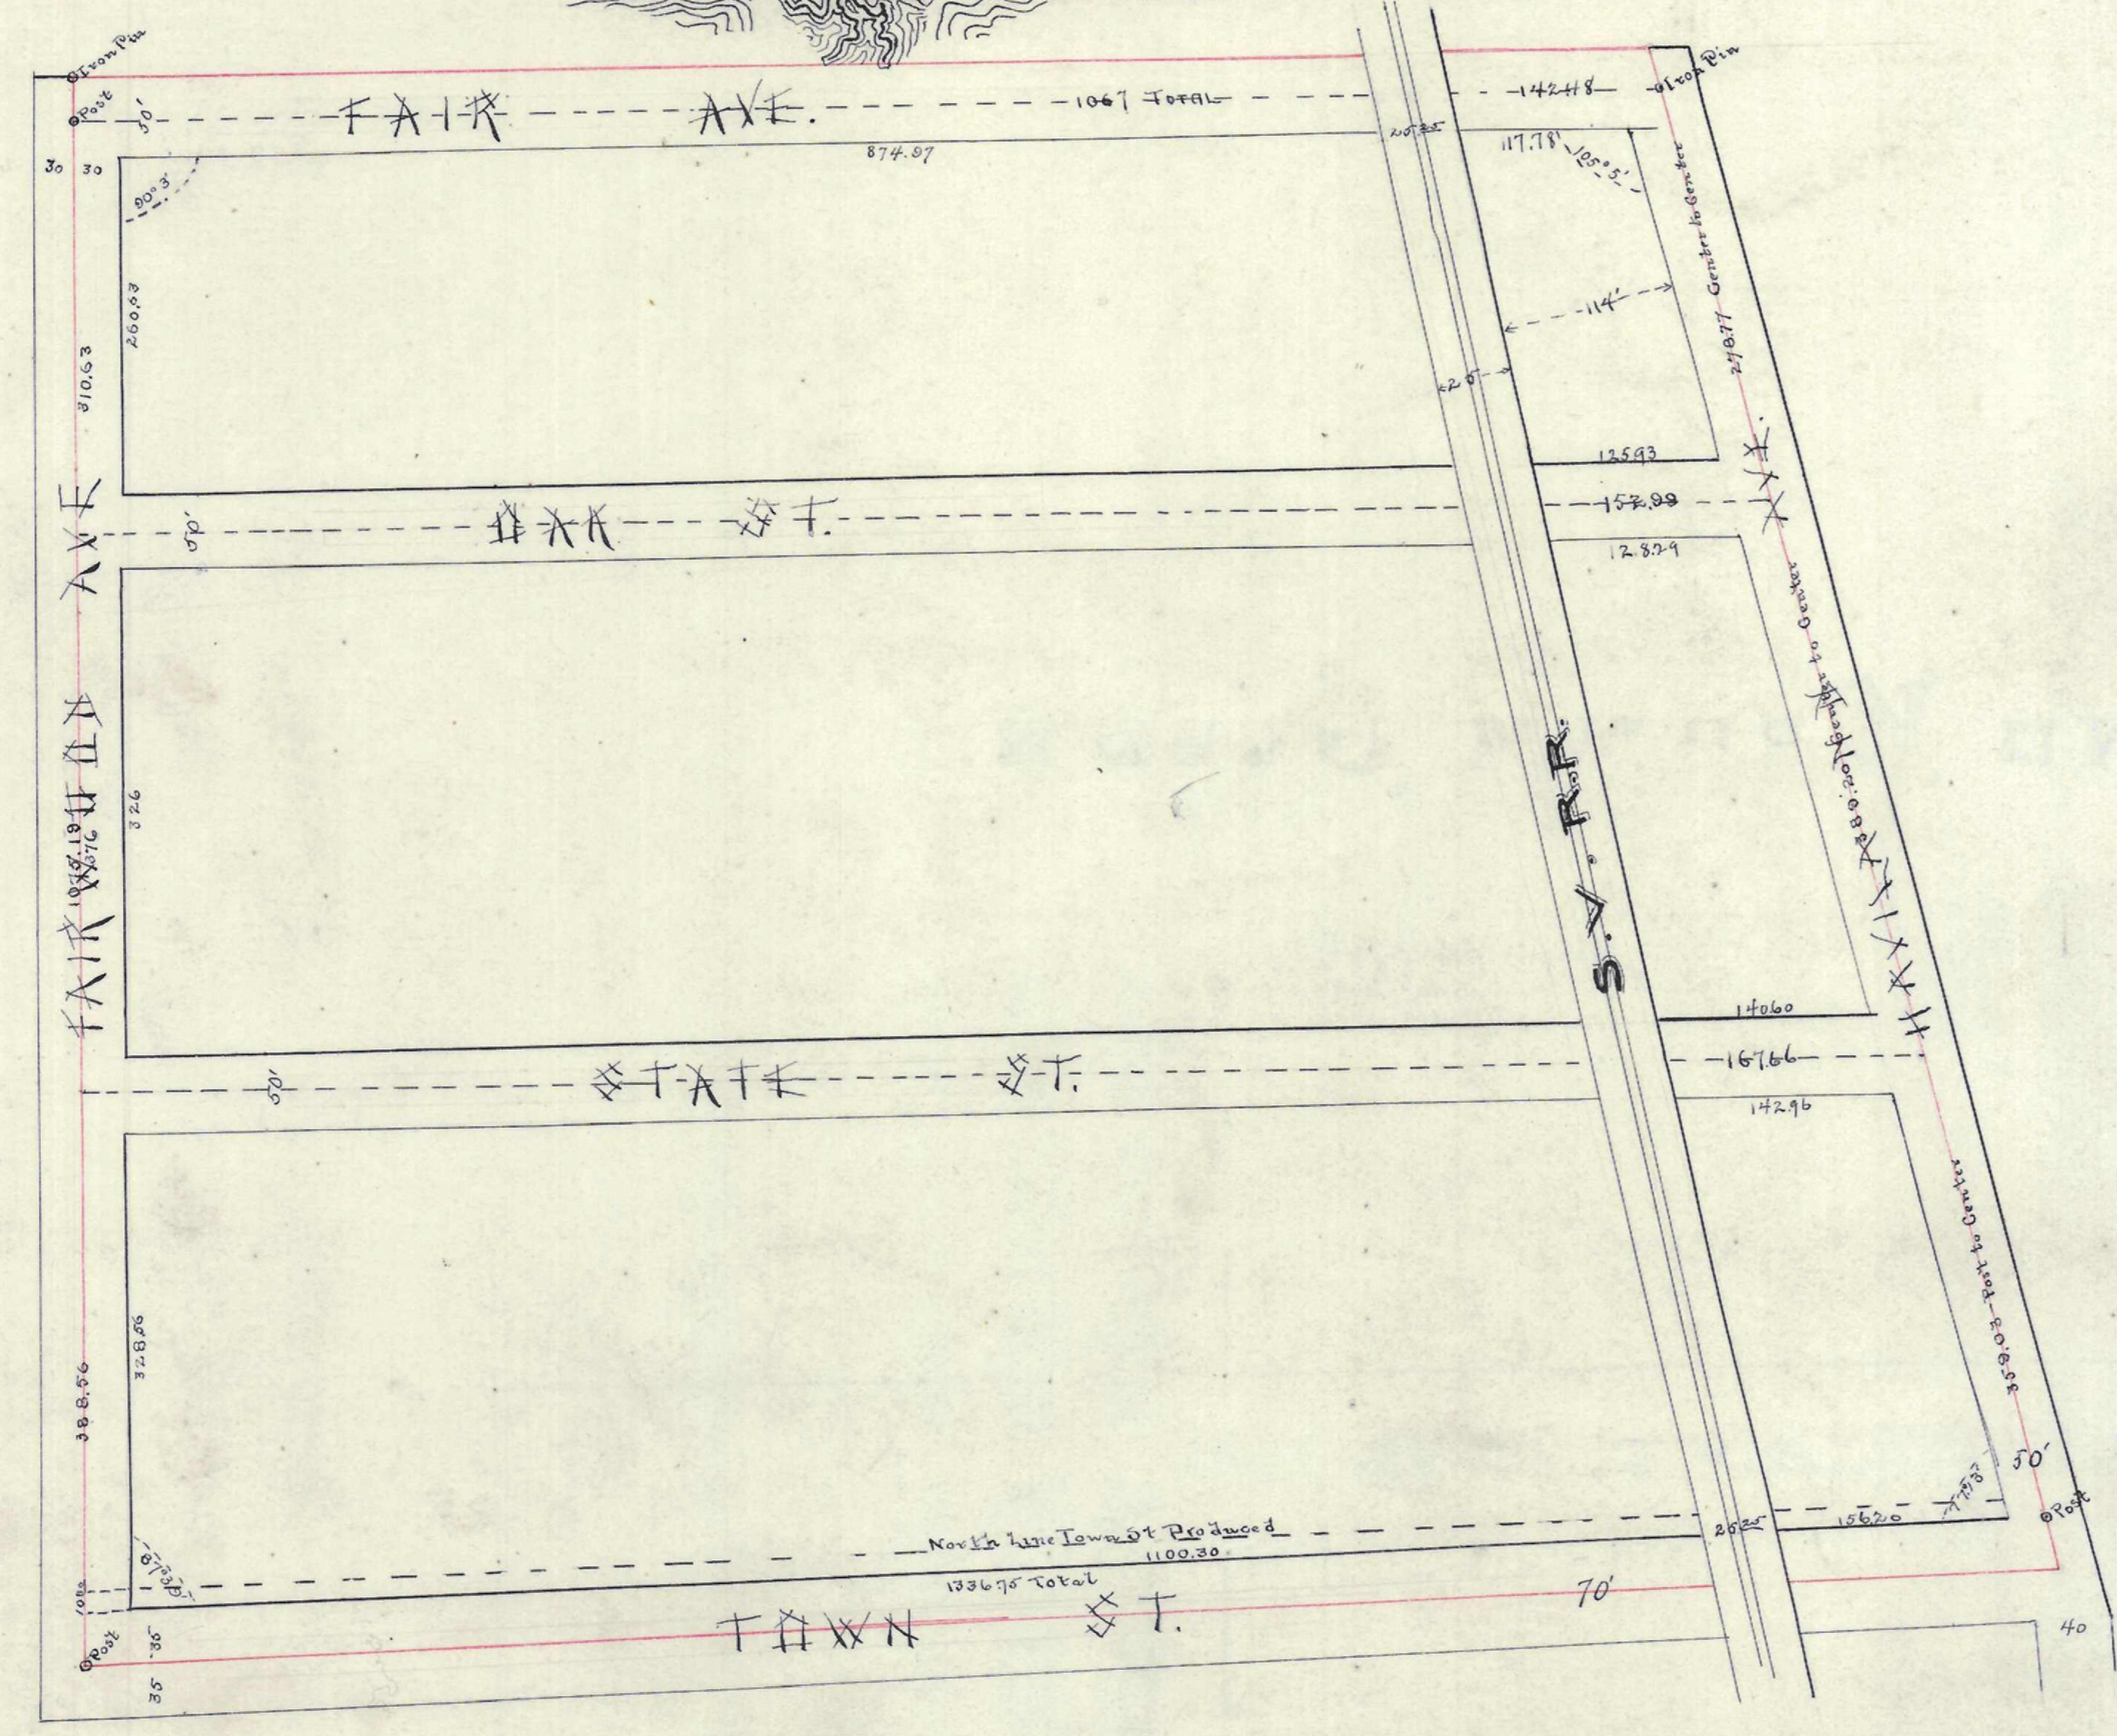


AMENDED PLAT OF STREETS.
Geo. Rhodes IN
Fairwood Addition.
 H.K. Knoff
 INDEX 1890

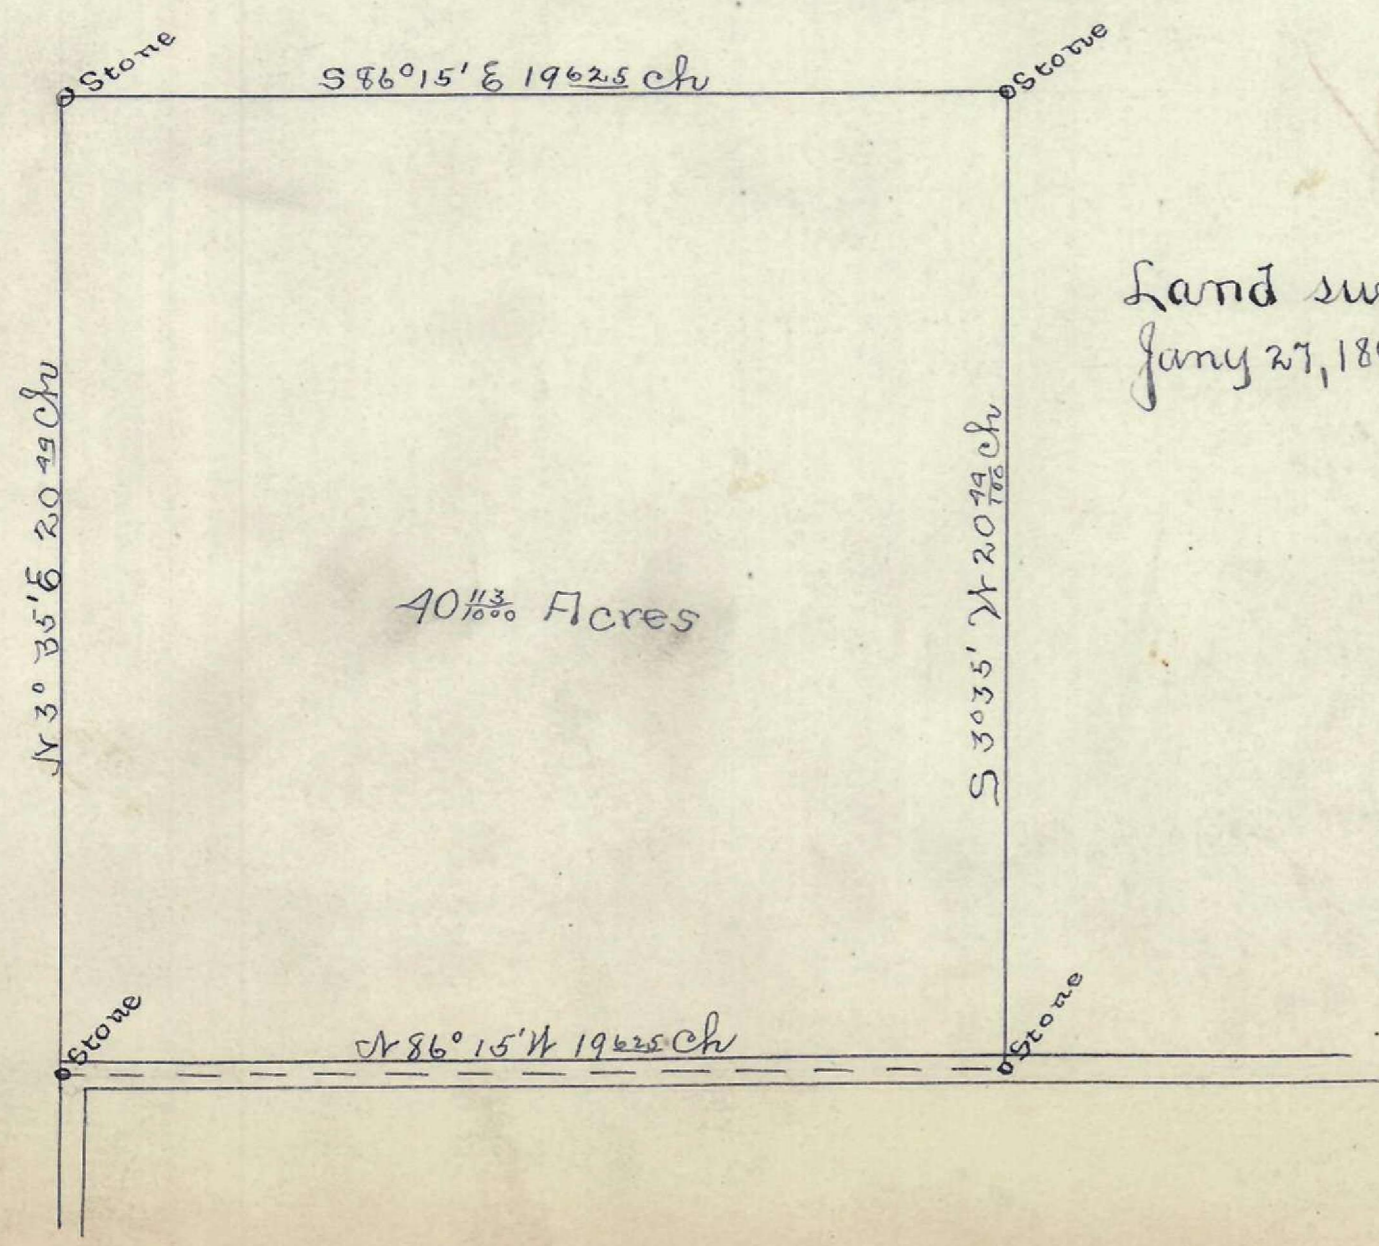

PLAT OF PART OF
MARTIN'S STAGES
FAIRWOOD ADDITION
 COLUMBUS, O. INDEX

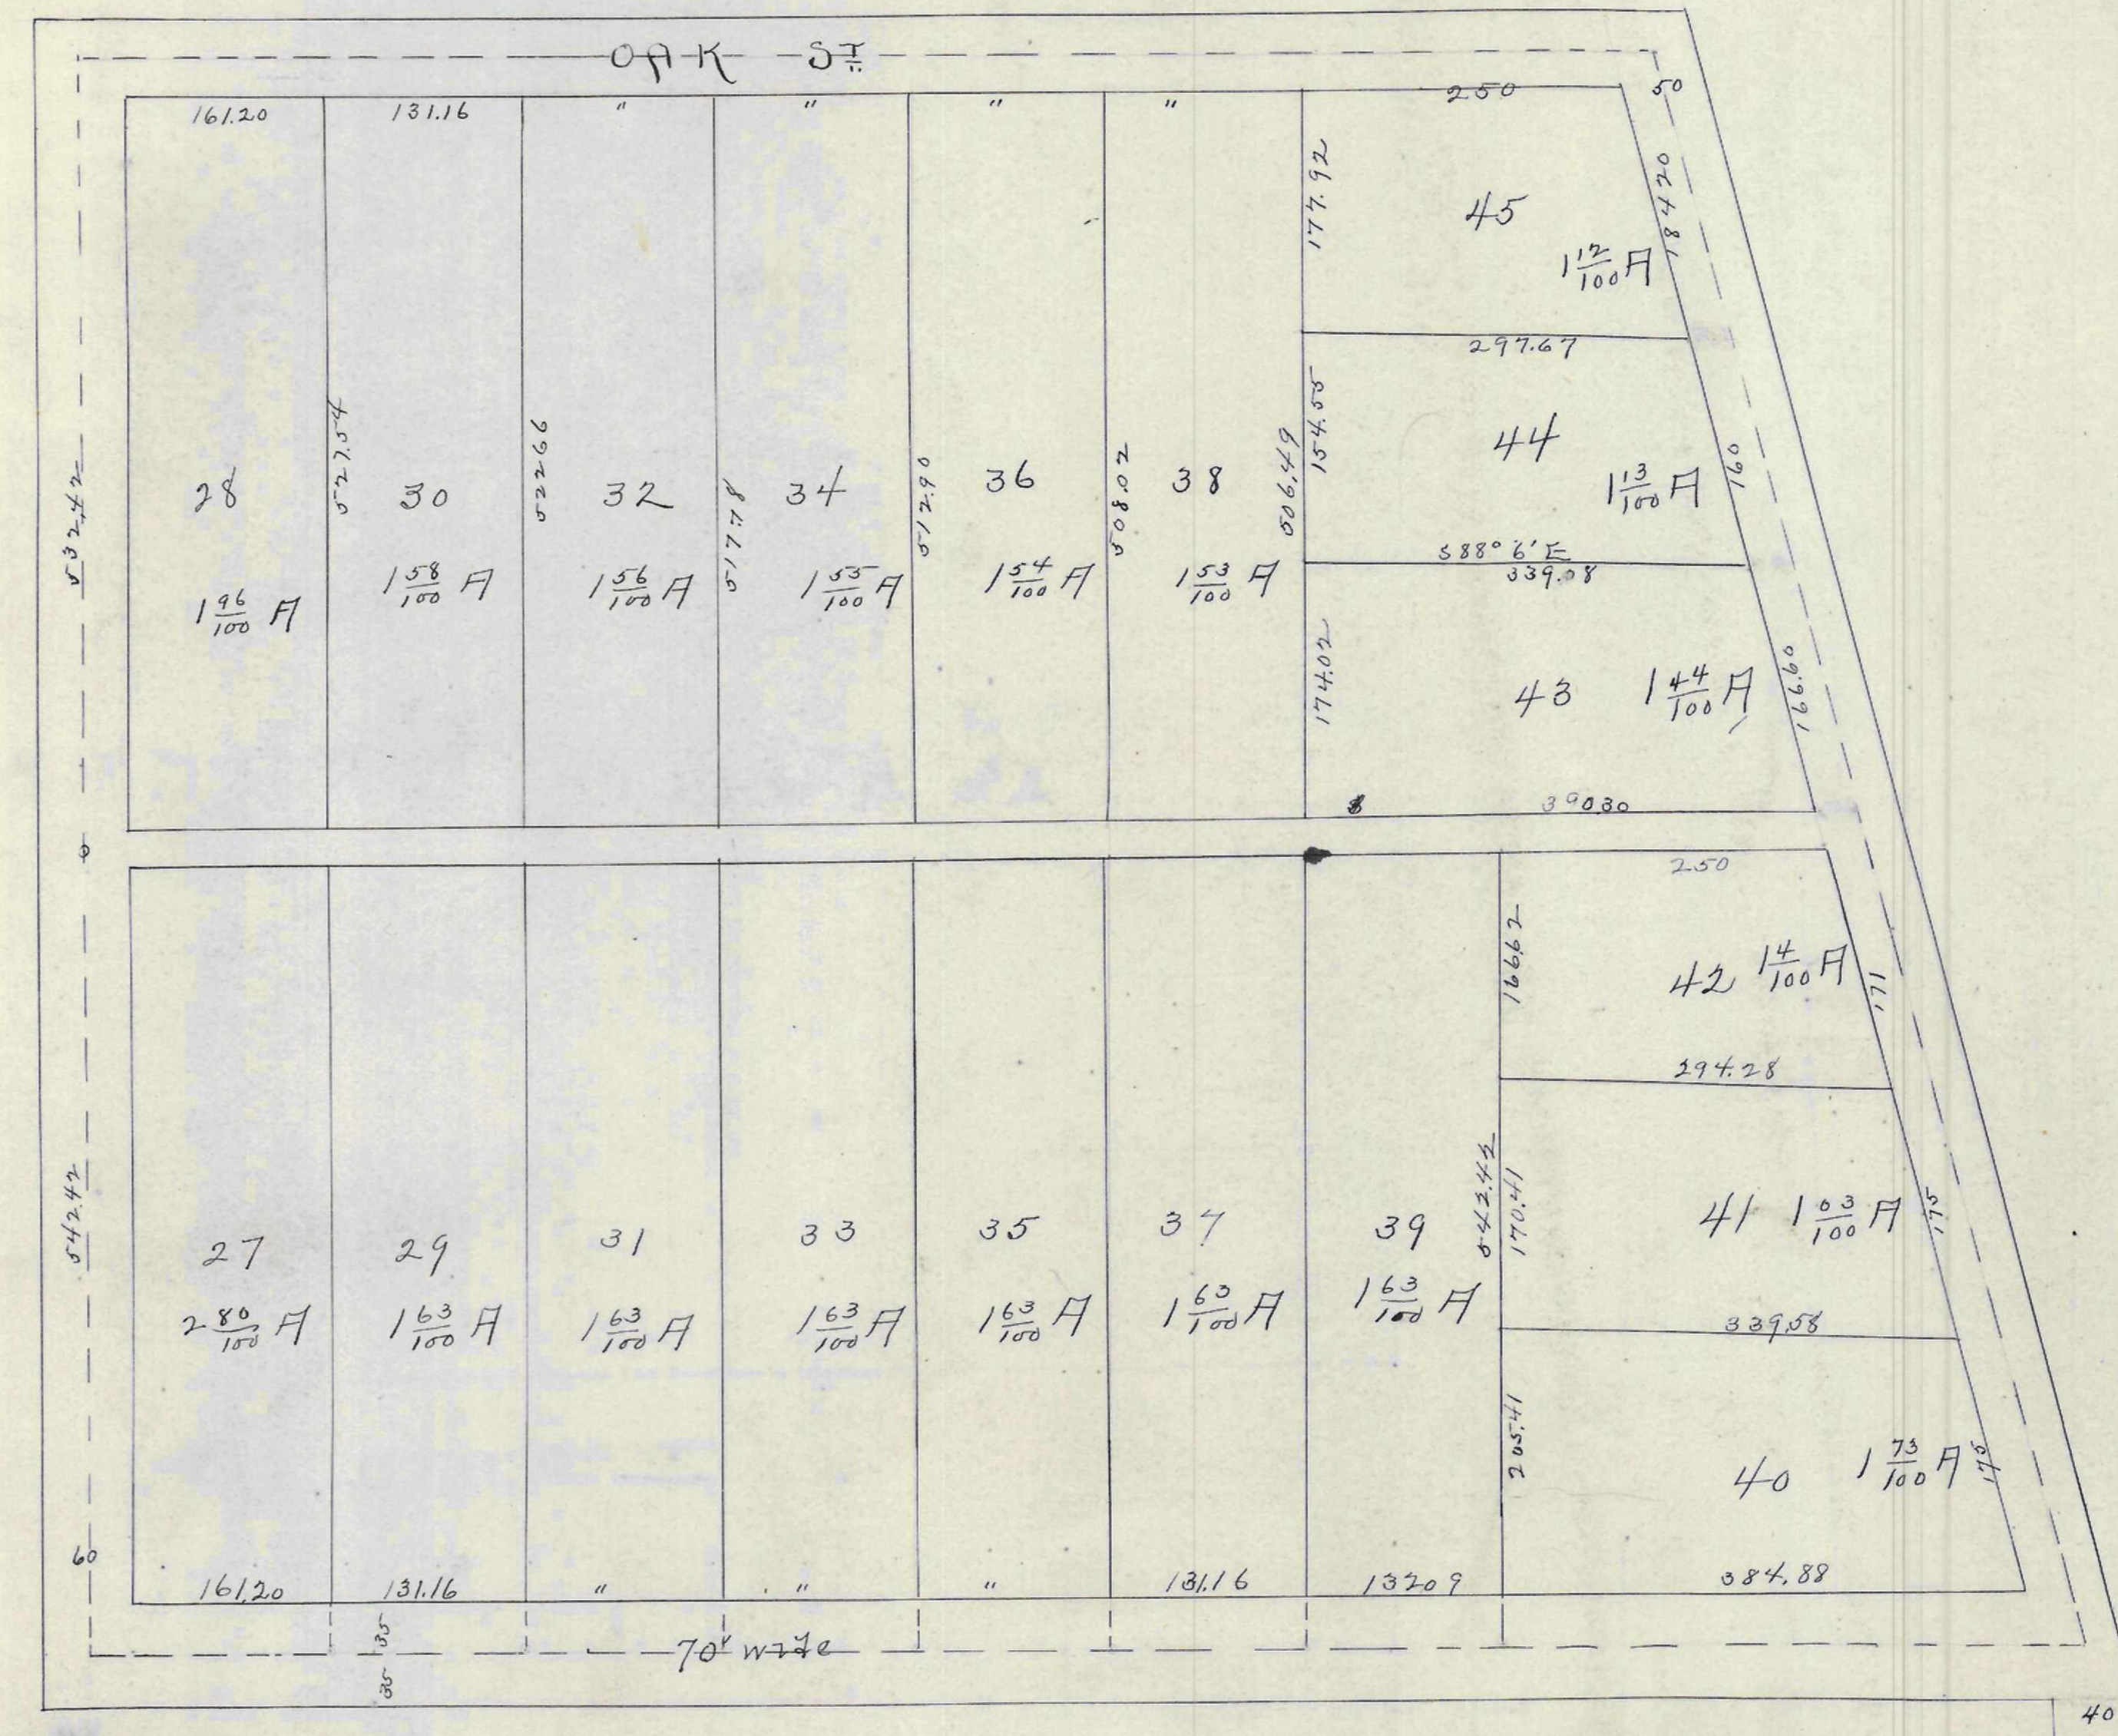

Plat
 of
 Land surveyed for Jefferson Mosier Madison Tp
 by J.J. Dun Co Sur
 per H.K. Knoff
 Sply
 INDEX