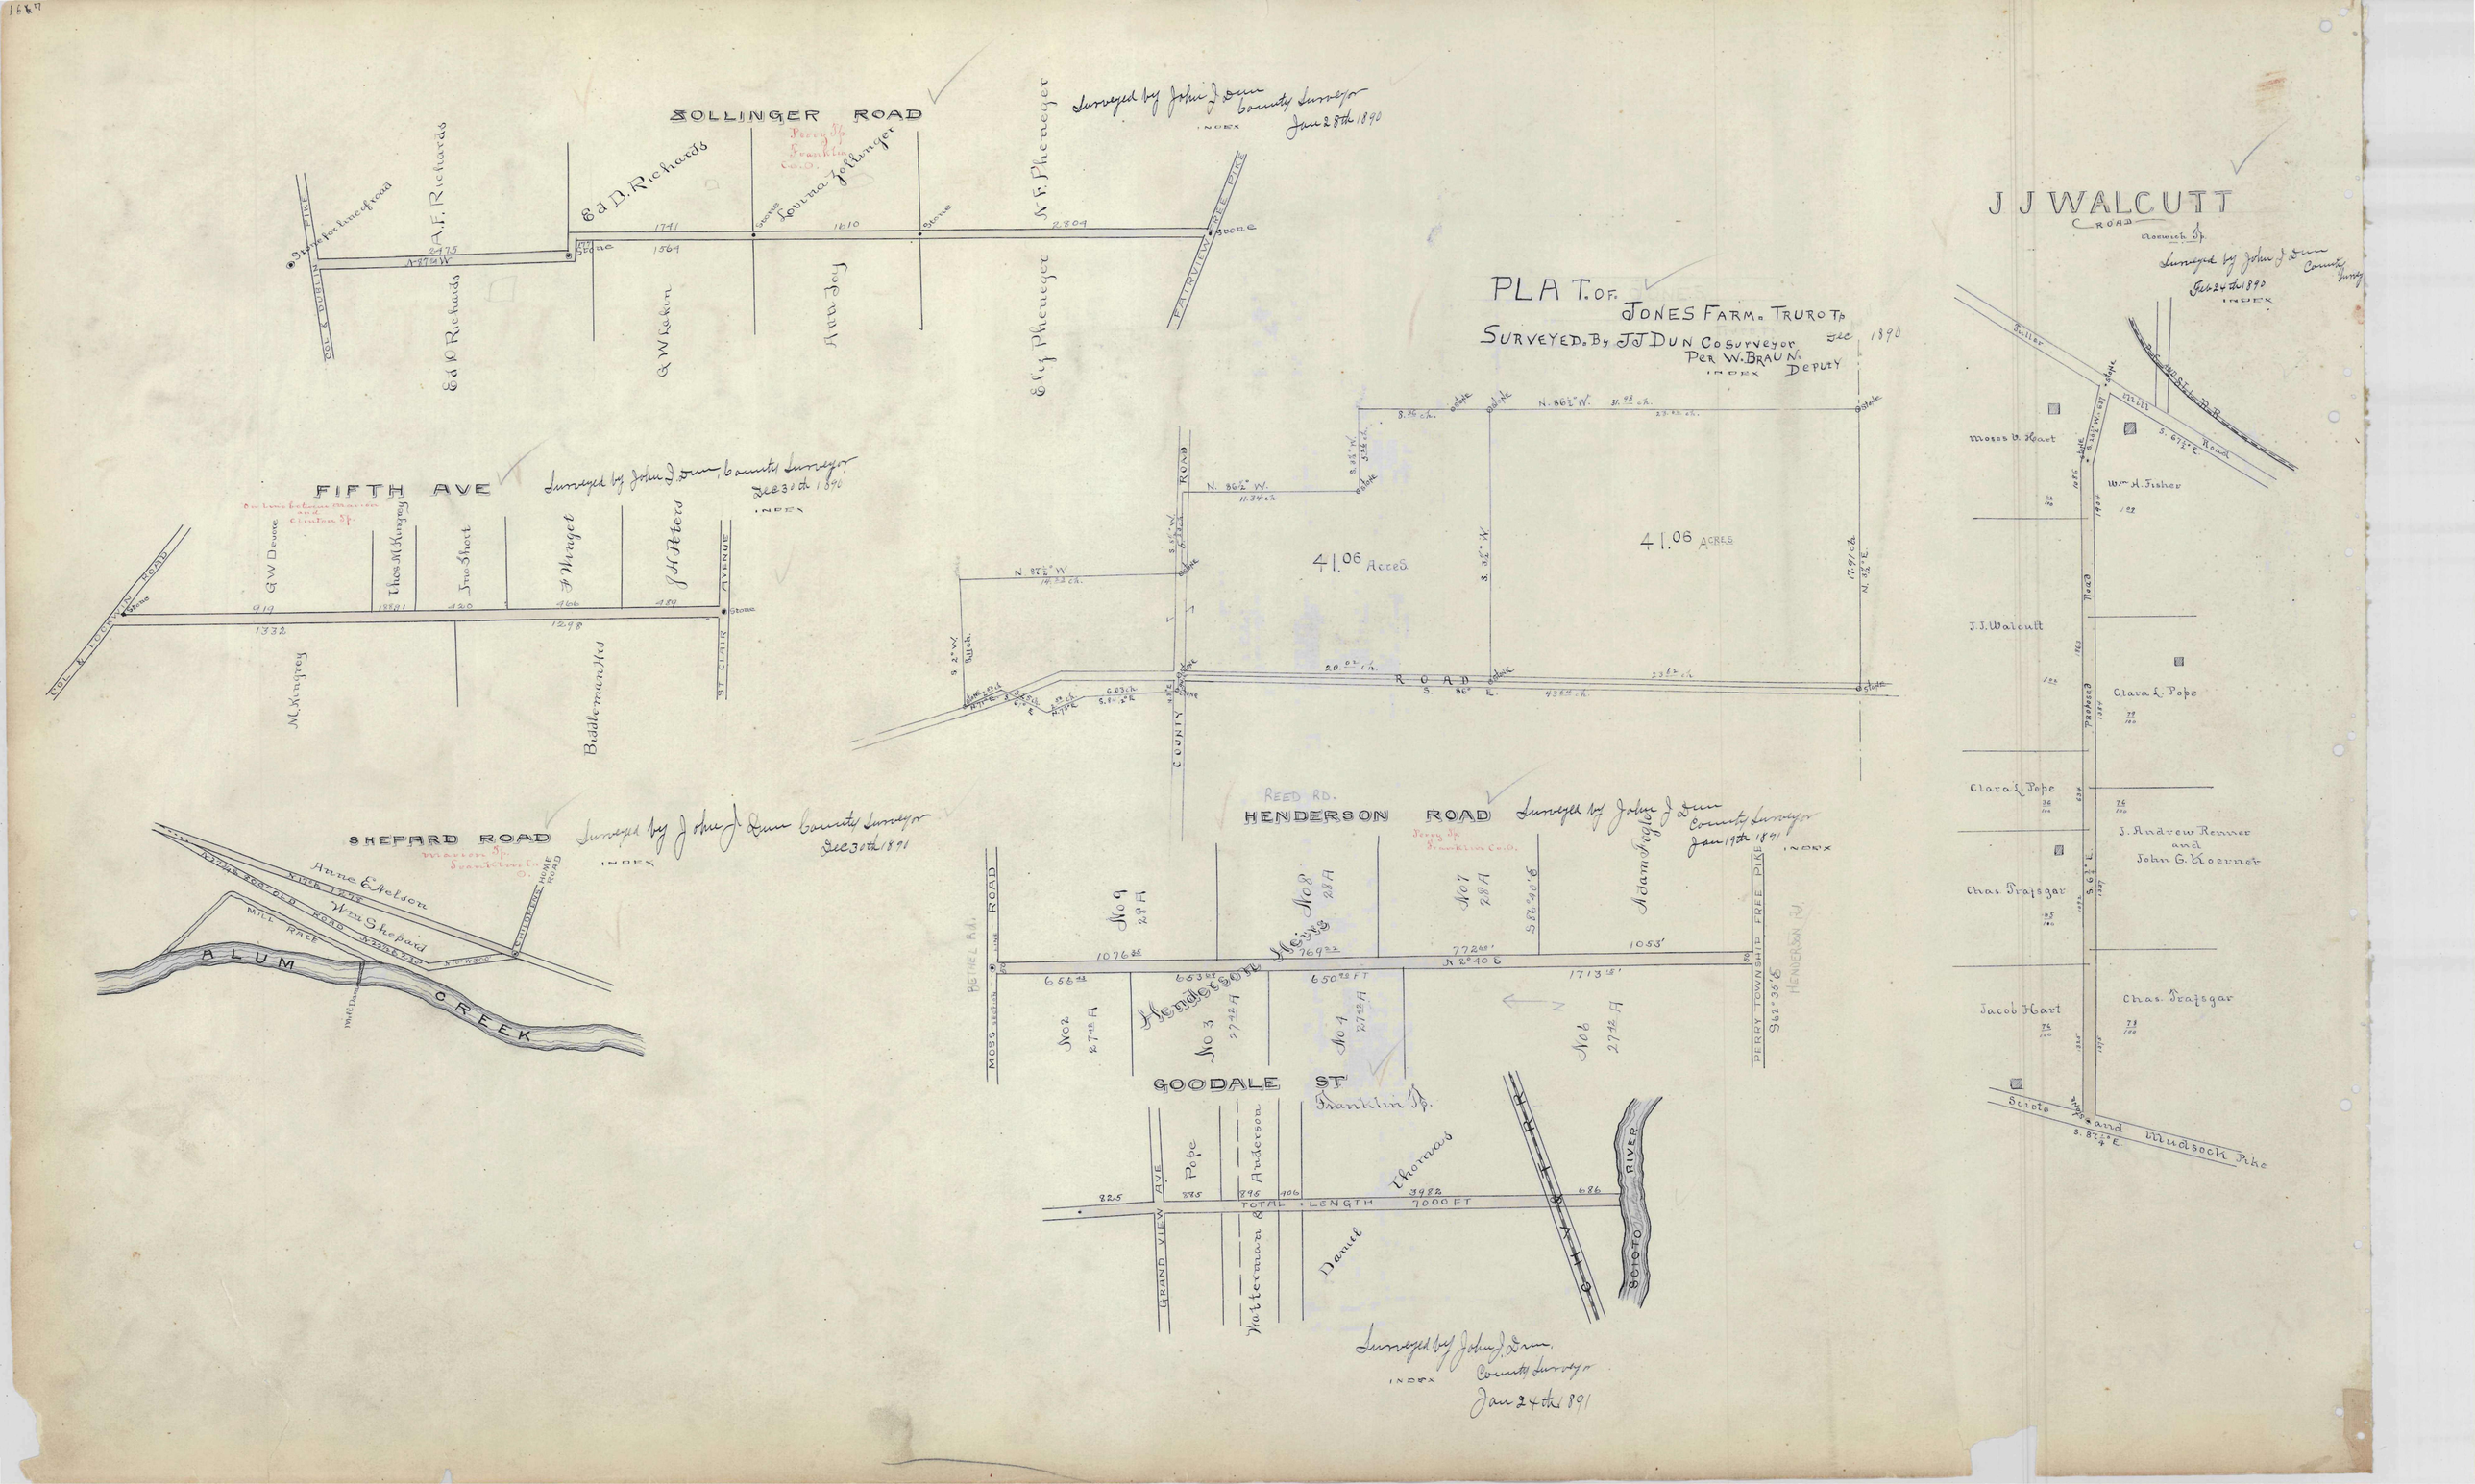
SOLLINGER ROAD
Surveyed by John J Dunn County Surveyor June 28th 1890
INDEX
Perry Tp. Franklin Co. O.
Edd D. Richards
Louina Sollinger
N. F. Pheneger
A. F. Richards
Ed D Richards
G W Lockin
Ann Joy
Eliz Pheneger
COL & DUBLIN PIKE
PATTERSVILLE FREE PIKE
Stone
FIFTH AVE
Surveyed by John J Dunn County Surveyor Dec 31st 1890
INDEX
Our Line between Marion and Clinton Tp.
G W Devore
Thos M Kingrey
Jno Short
F Wright
J H Peters
COL & TUCKWOOD ROAD
AVENUE
ST CLAIR
M. Kingrey
Biddlemanhd
SHEPARD ROAD
Surveyed by John J Dunn County Surveyor Dec 30th 1891
INDEX
Marion Tp. Franklin Co. O.
Anne E Nelson
W m Shepard
NEW PATH
OLD ROAD
MILL RACE
ALUM CREEK
COLUMBUS HOME ROAD
PLAT OF JONES FARM. TURO Tp
SURVEYED. BY J J DUN CO SURVEYOR DEC 1890
PER W. BRAUN. DEPUTY
INDEX
N. 86½° W. 31.88 ch.
N. 86½° W.
11.34 ch.
N. 87½° W.
14.53 ch.
41.06 Acres
41.06 ACRES
COUNTY ROAD
ROAD
S. 86° E.
43.84 ch.
HENDERSON ROAD
Surveyed by John J Dunn County Surveyor Jan 19th 1891
INDEX
REED RD.
Perry Tp. Franklin Co. O.
No 9 28 A
No 8 28 A
No 7 28 A
Adam Fogler
Henderson Heirs
No 2 27½ A
No 3 27½ A
No 4 27½ A
No 6 27½ A
N 2° 40 6
1076.55
1053'
1713.5'
MOSS BETHEL RD.
PERRY TOWNSHIP FREE PIKE
HENDERSON RD.
GOODALE ST
Franklin Tp.
Pope
Hatteman & Anderson
Thornad
Daniel
GRAND VIEW AVE
TOTAL LENGTH 7000 FT
RAILROAD
SCIOTO RIVER
Surveyed by John J Dunn County Surveyor Jan 24th 1891
INDEX
J J WALCUTT ROAD
Surveyed by John J Dunn County Surveyor Feb 24th 1890
INDEX
Scioto
Mill
Road
Moses B. Hart
Wm H. Fisher
J. J. Walcutt
Clara L. Pope
Proposed Road
J. Andrew Renner and John G. Koerner
Chas. Frajsgar
Jacob Hart
Scioto and Mudsock Pike
S. 87¾° E.
S. 67½° E.