



PLAT

of
Part of Sydney L Chaffee's Subn as surveyed
by J J Dun for H H Knapp Esq
1890

Note - Distances given in green ink are old plat distances and call for center of High Street
In W. Woodruff's sub. The plat is called for side of High St hence a larger shortage
in his sub.

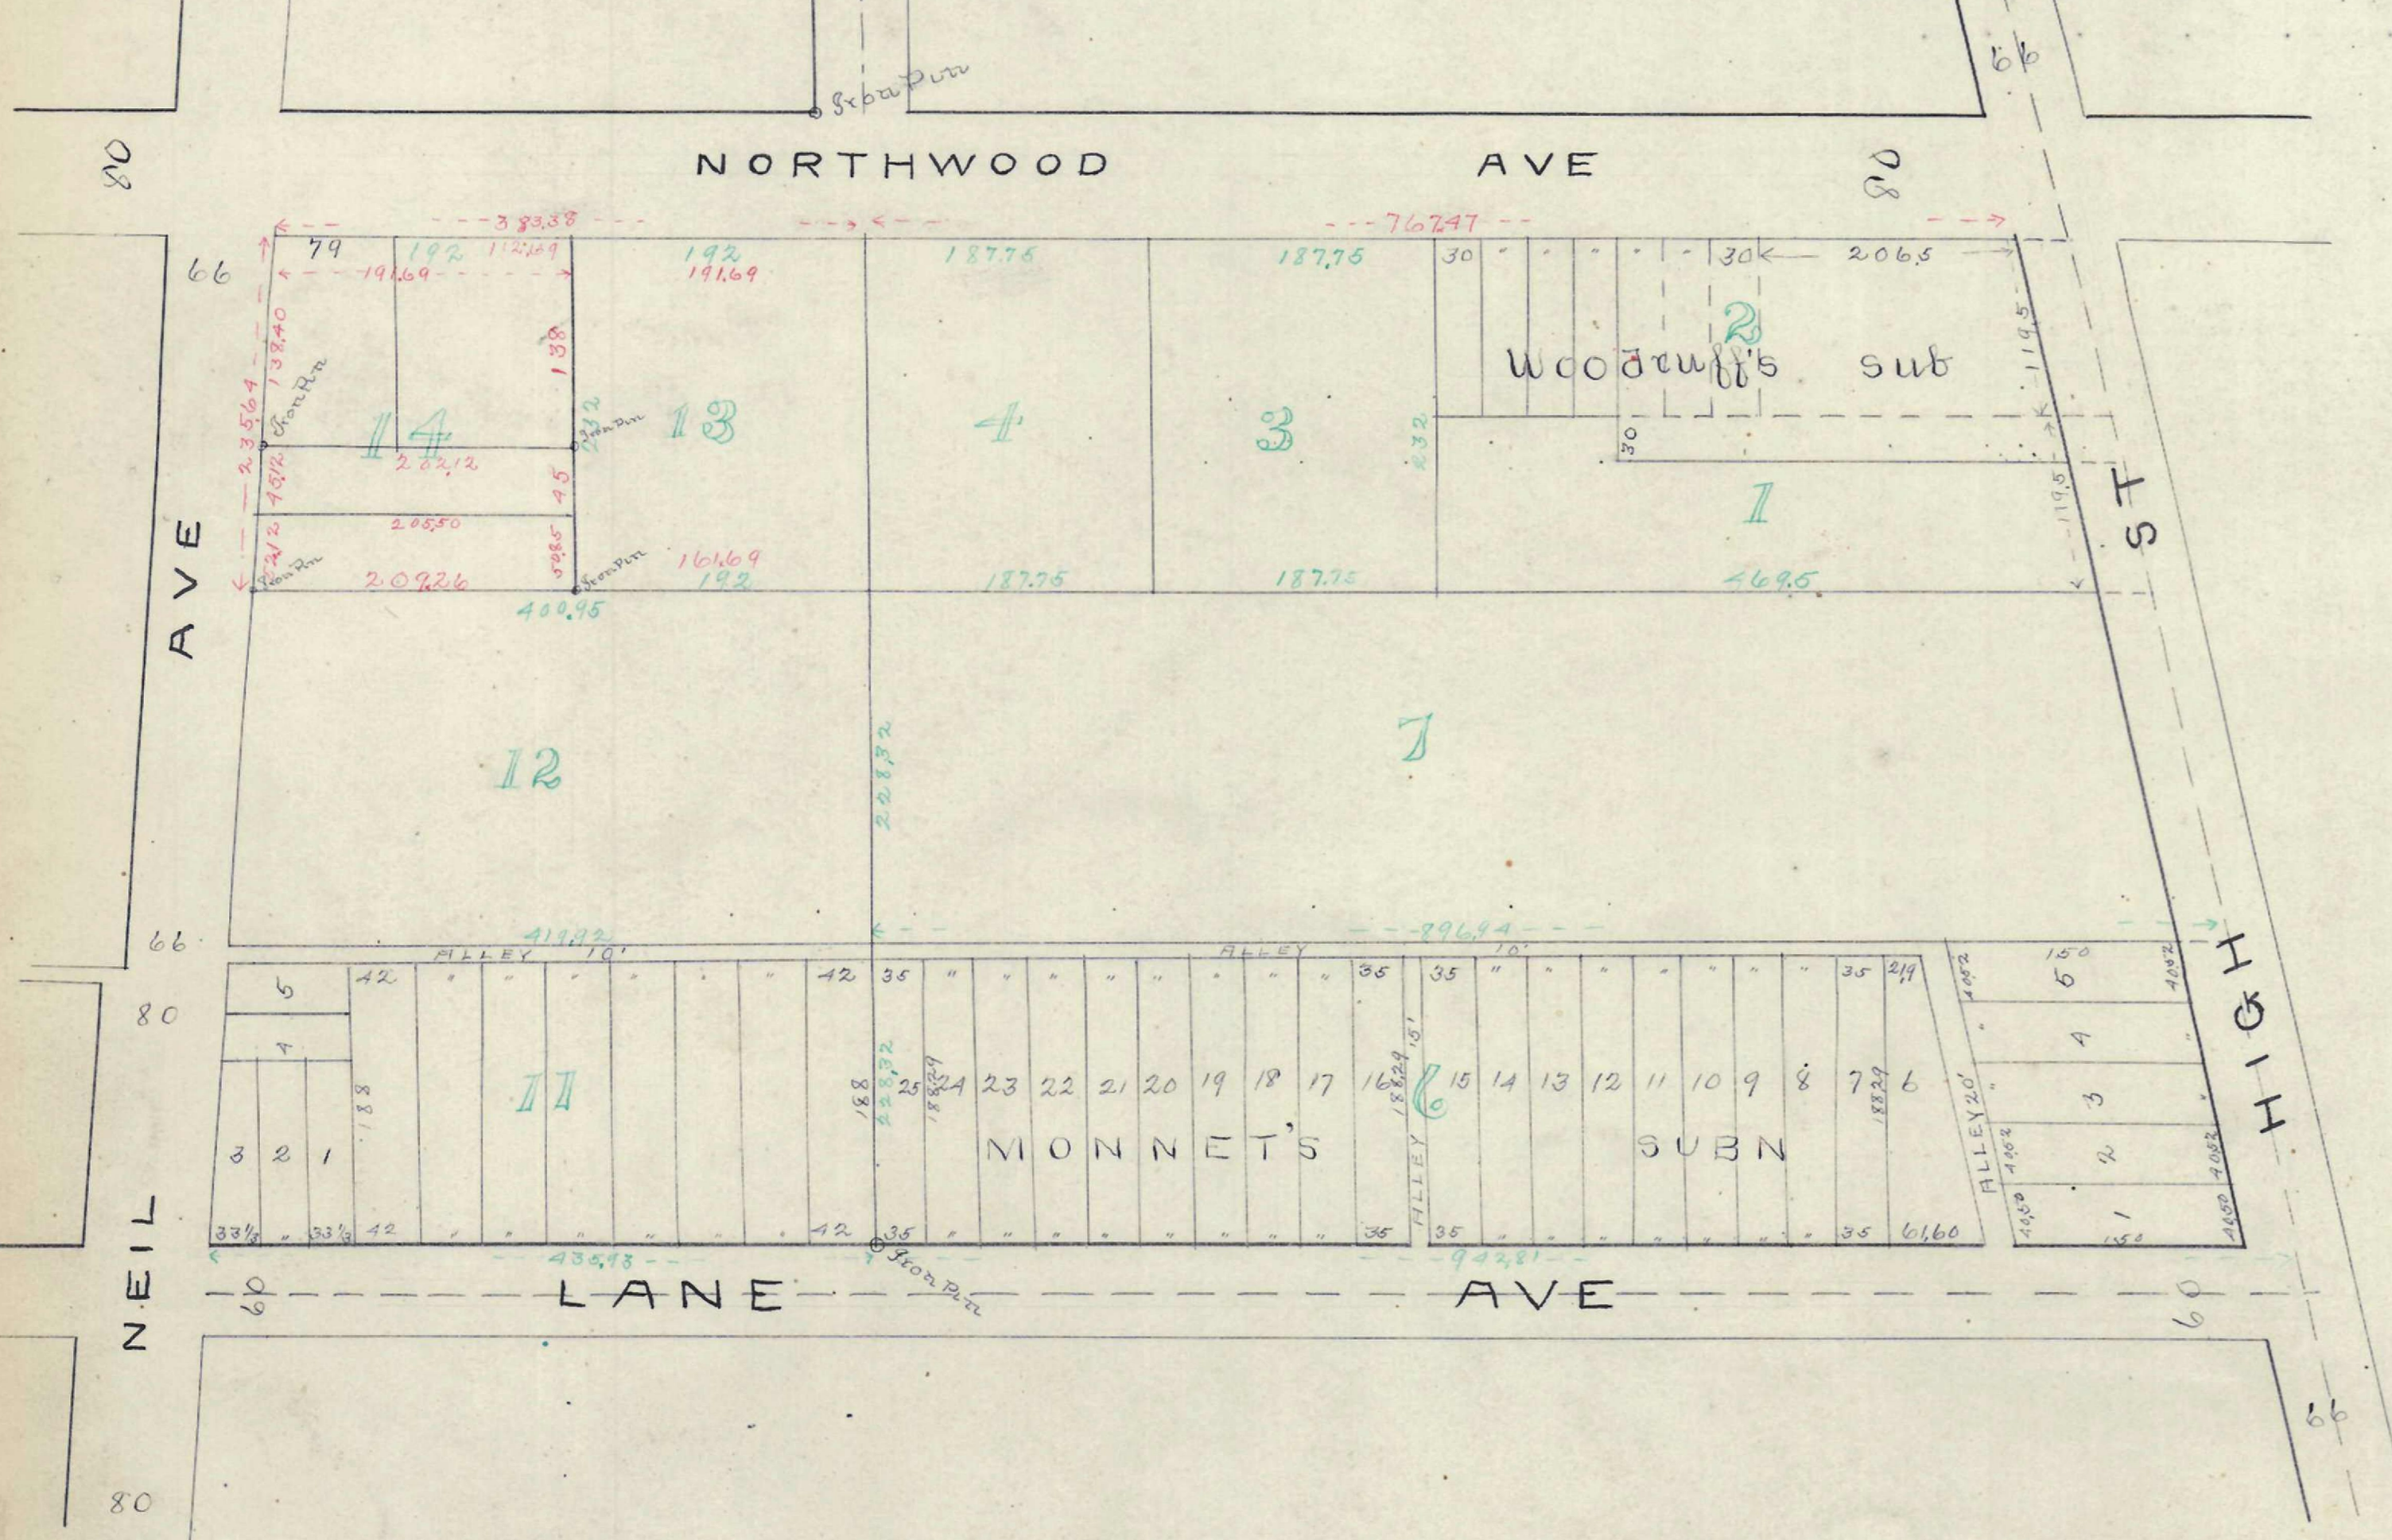

College Place
Addition

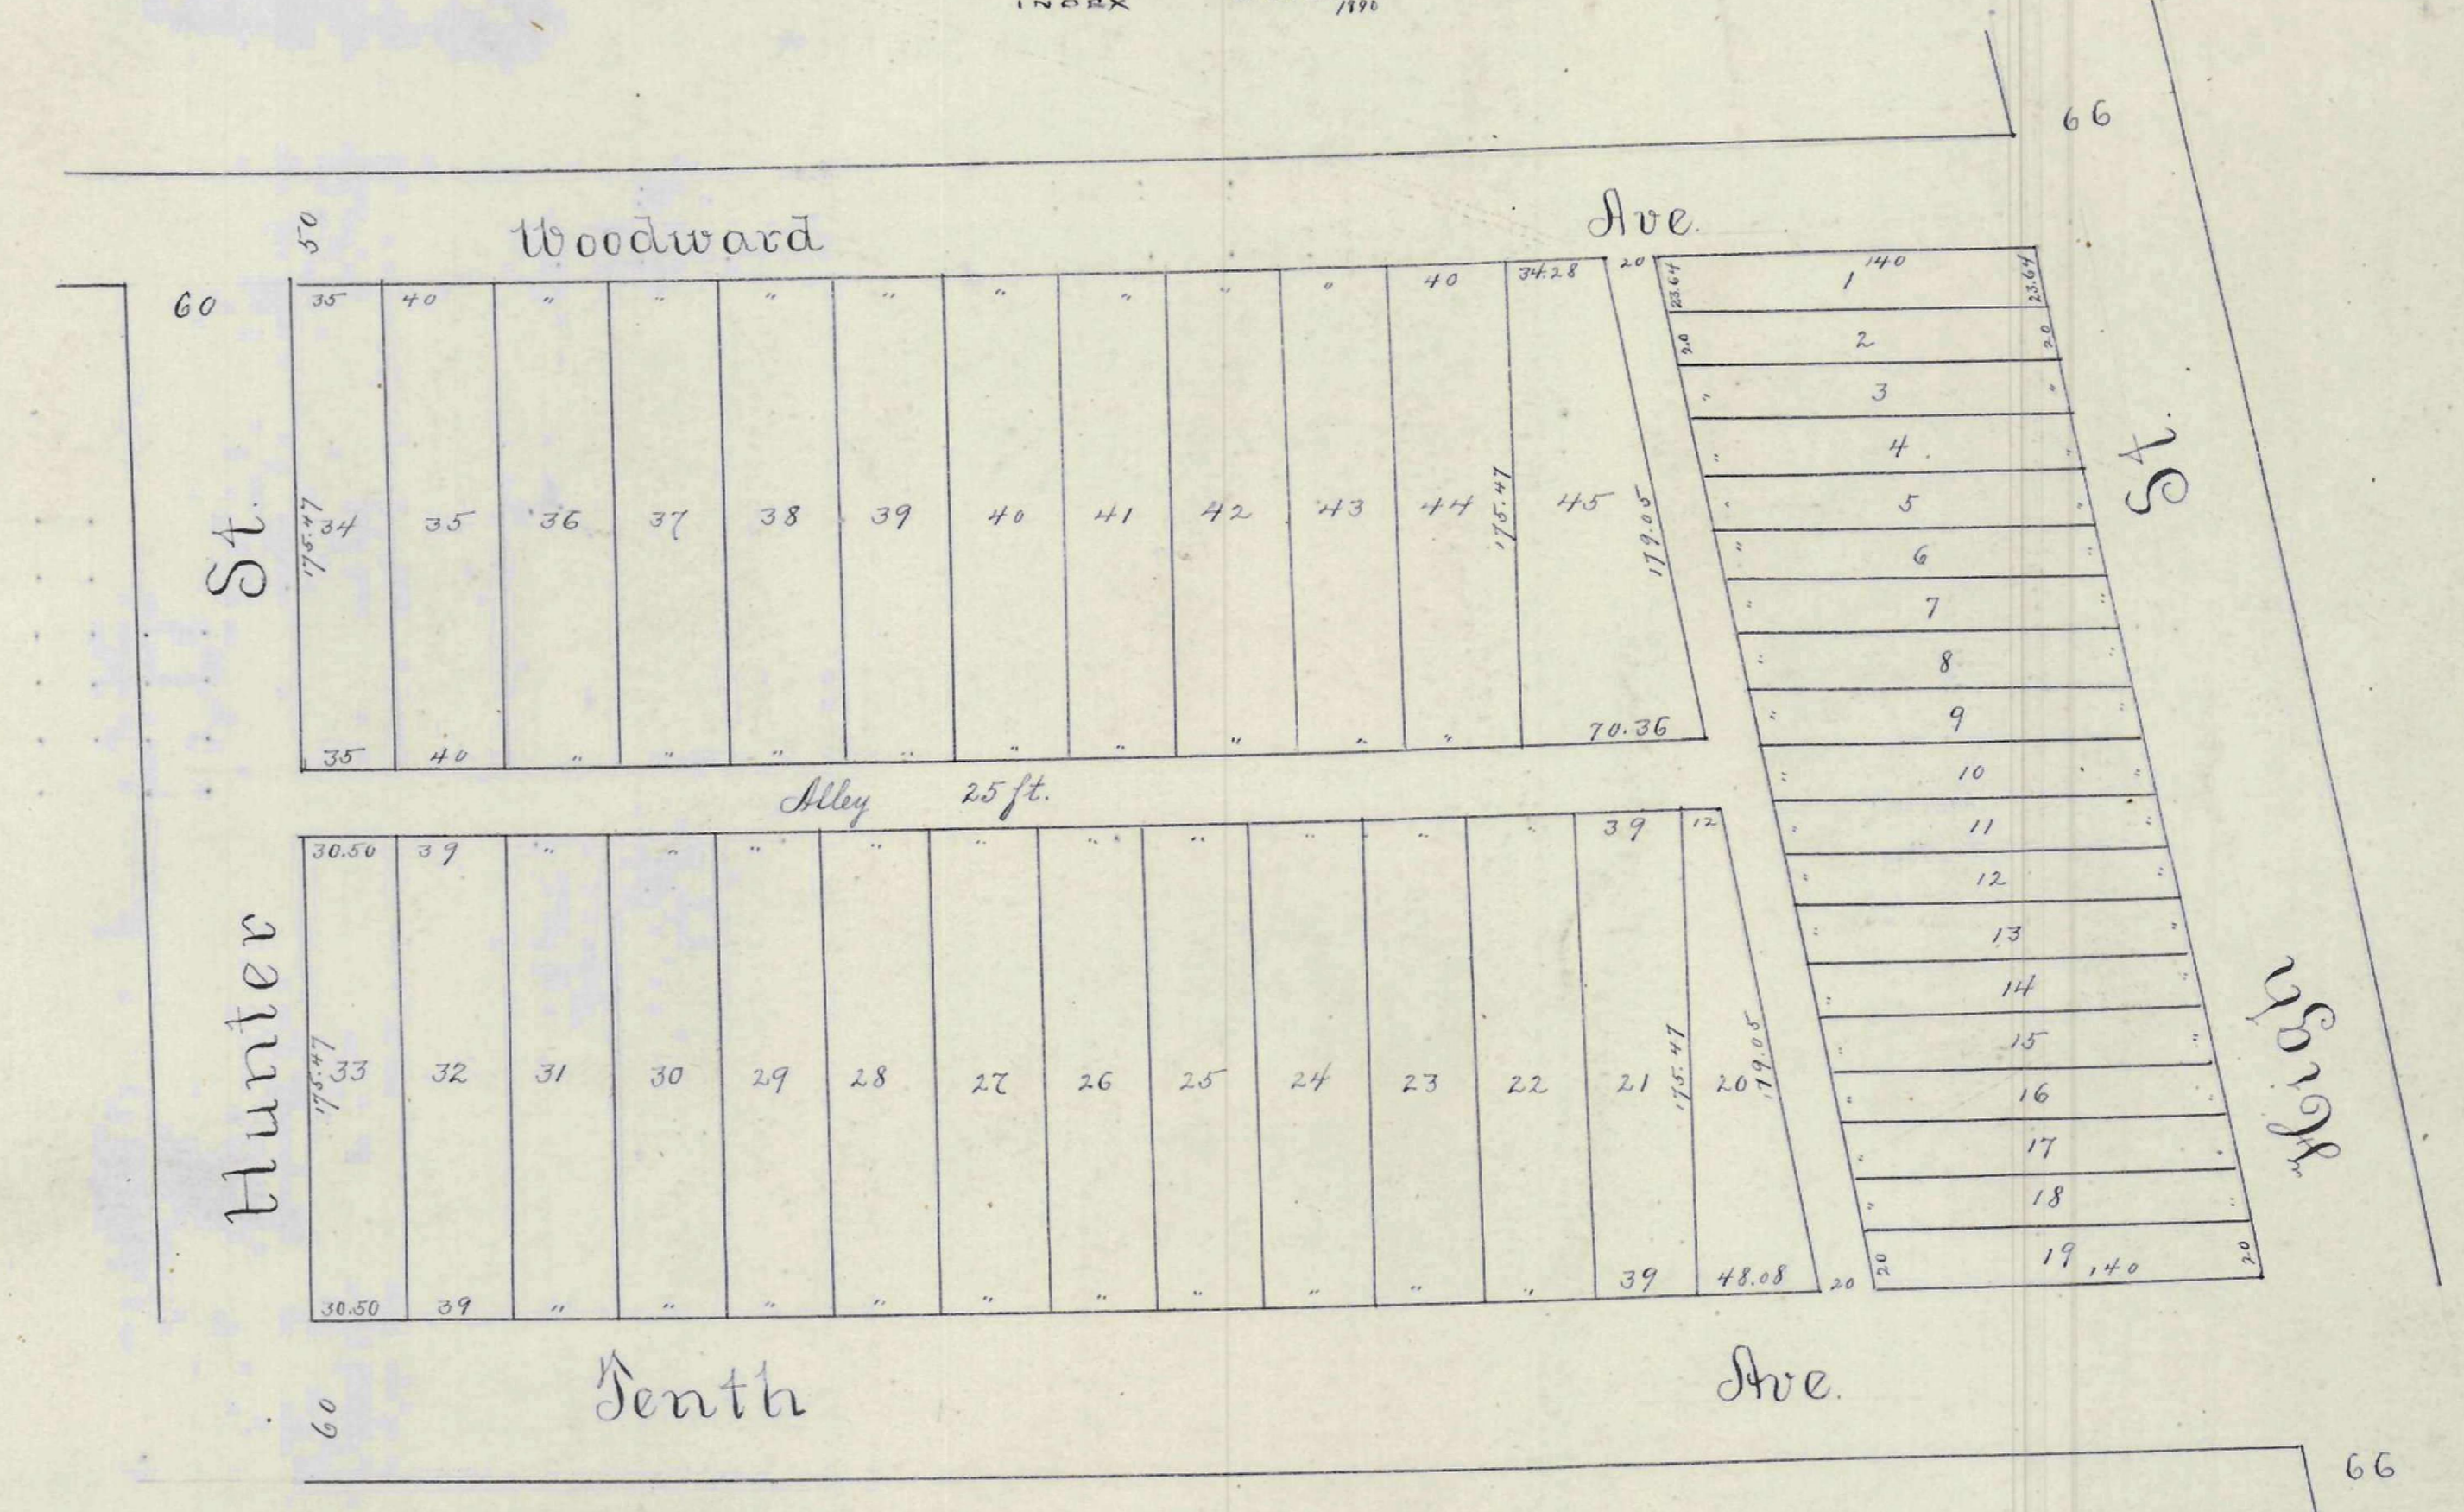

1890

1895