PLAT
OF
THE MASON DITCH

Mifflin and Truro Townships
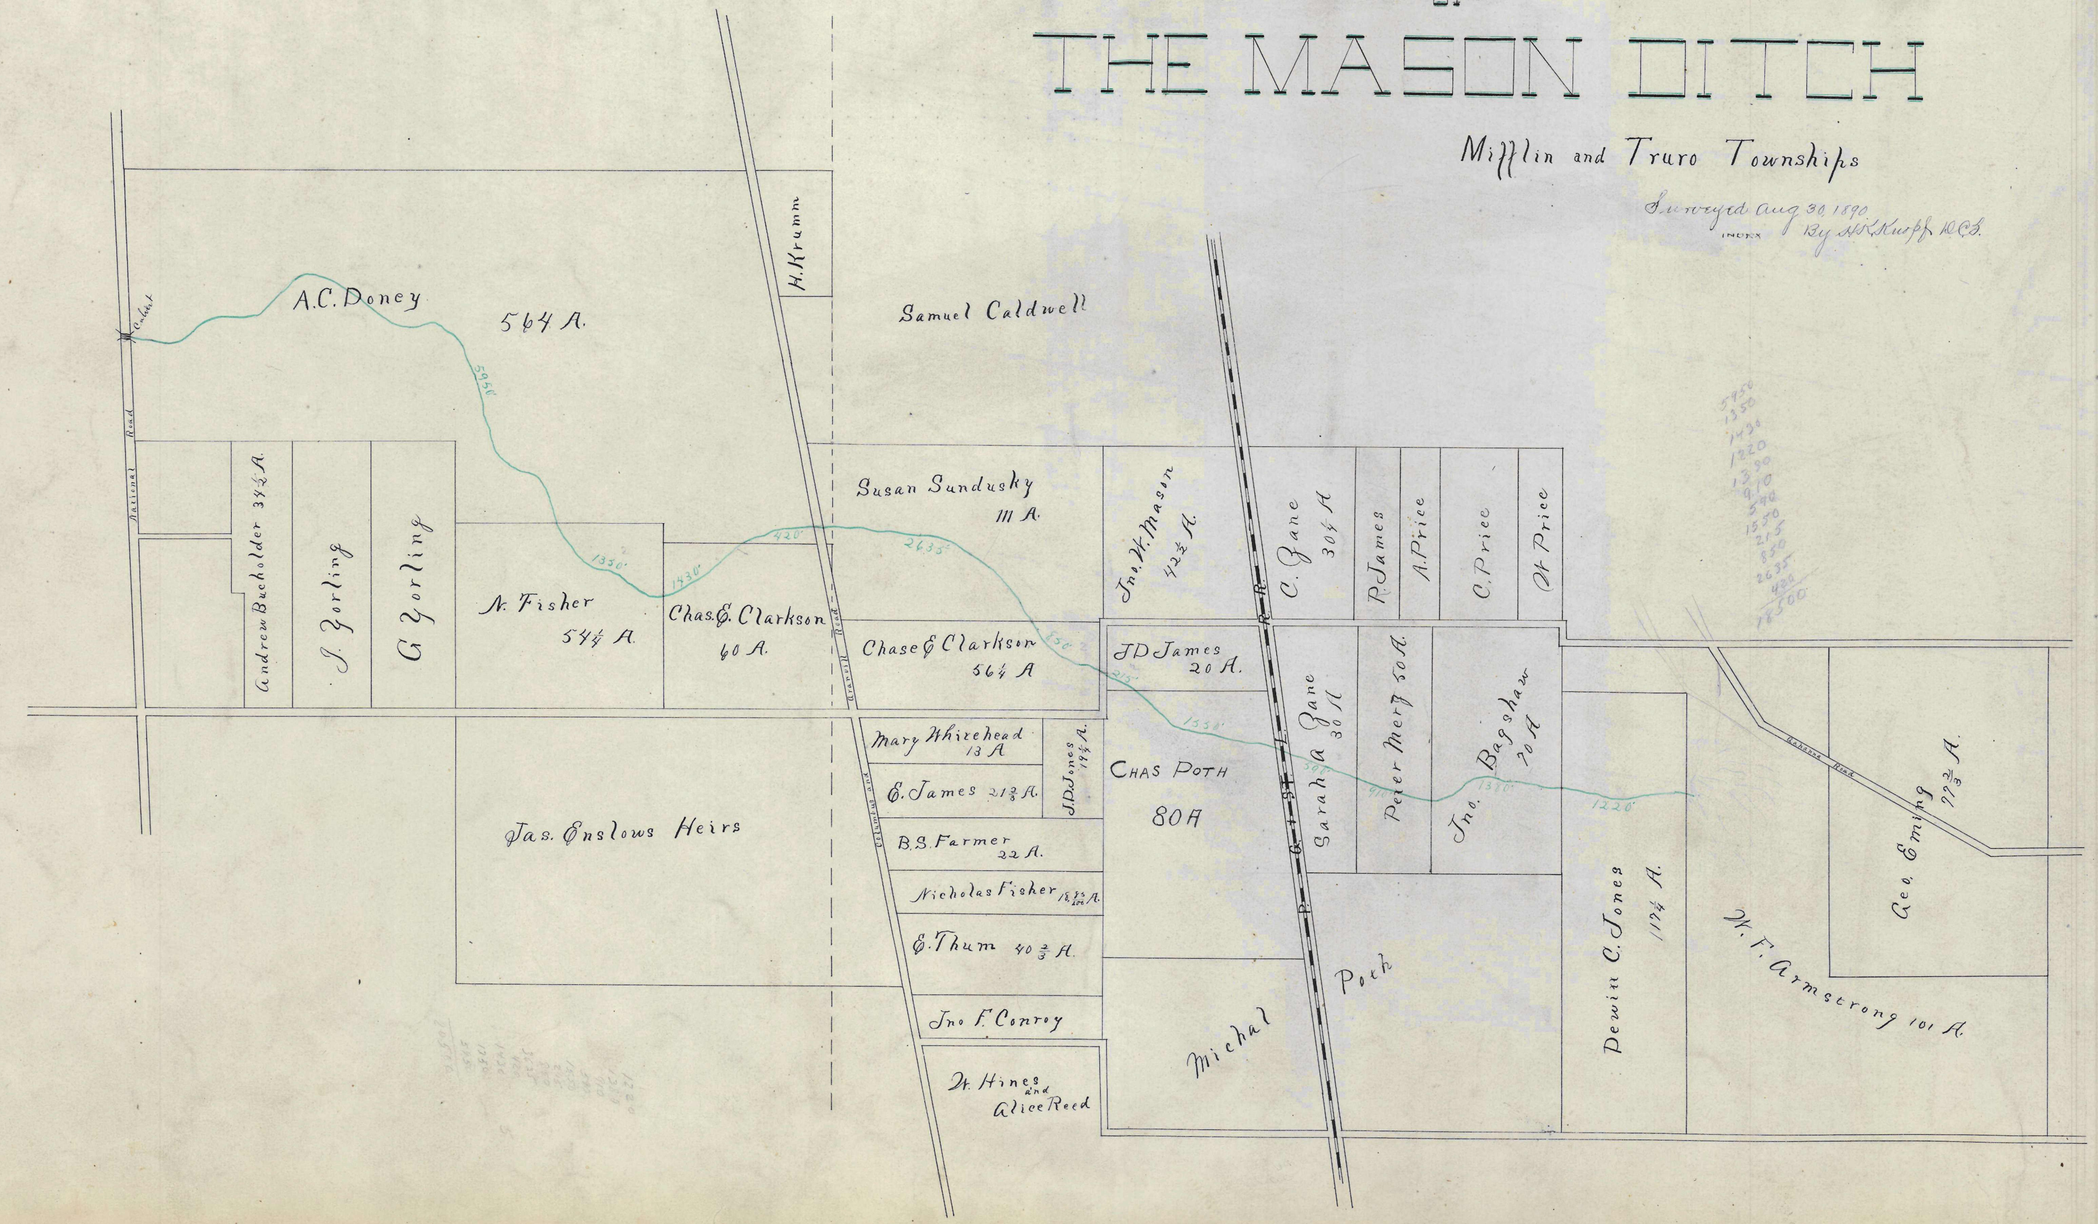
Surveyed Aug 30 1890
By W.K. Krupp W.C.S.